

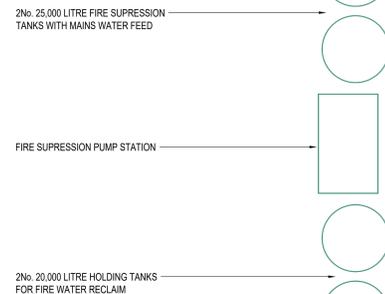
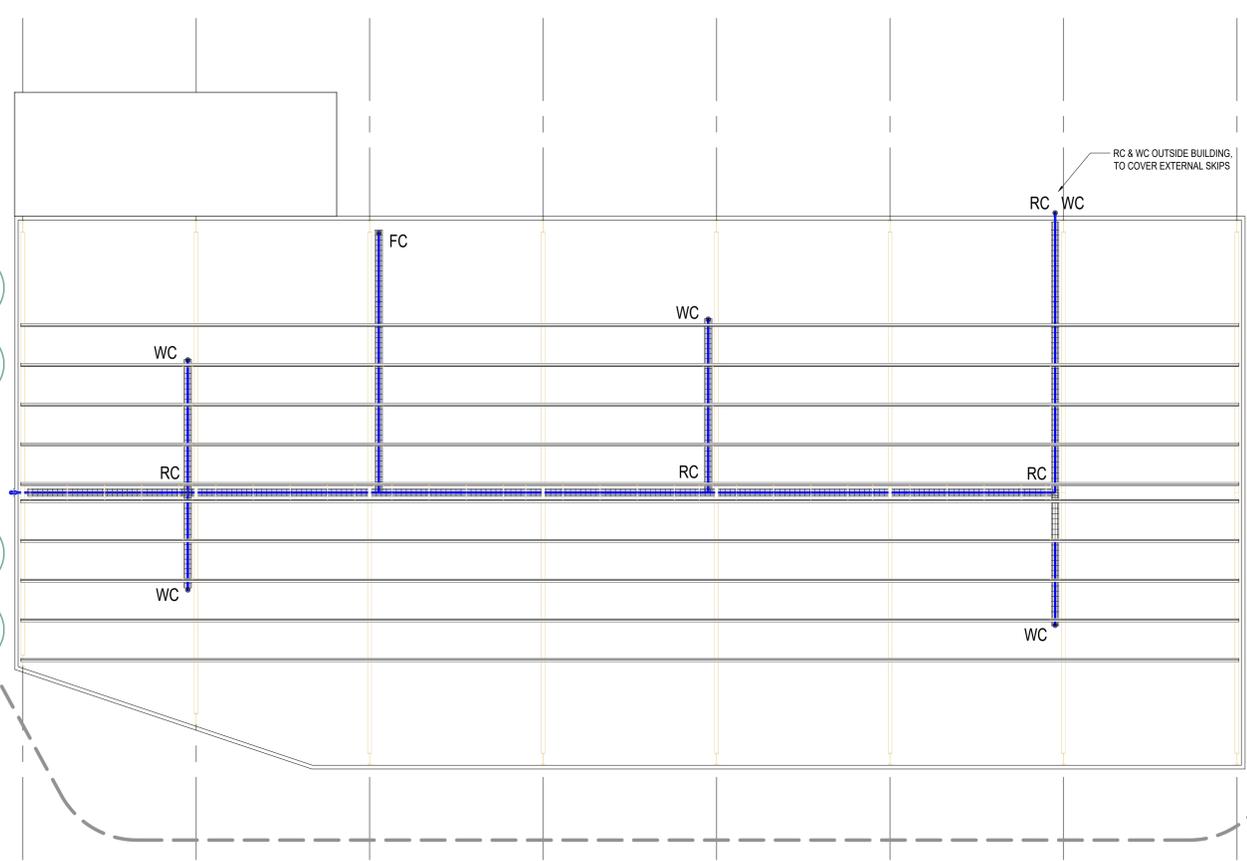
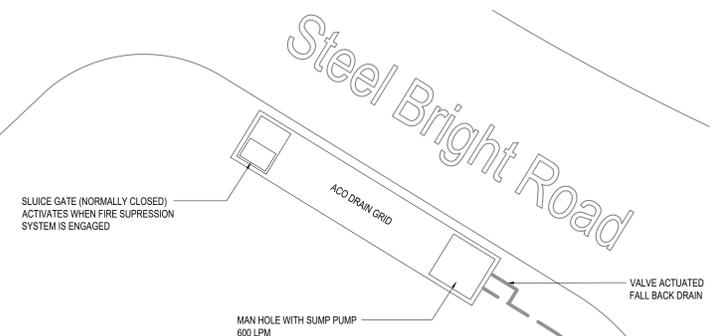


KEY:
 RC - ROTATING CAMERA (HIKVISION)
 WC - WATER CANNON (FORADE)
 FC - FIXED CAMERA (HIKVISION)

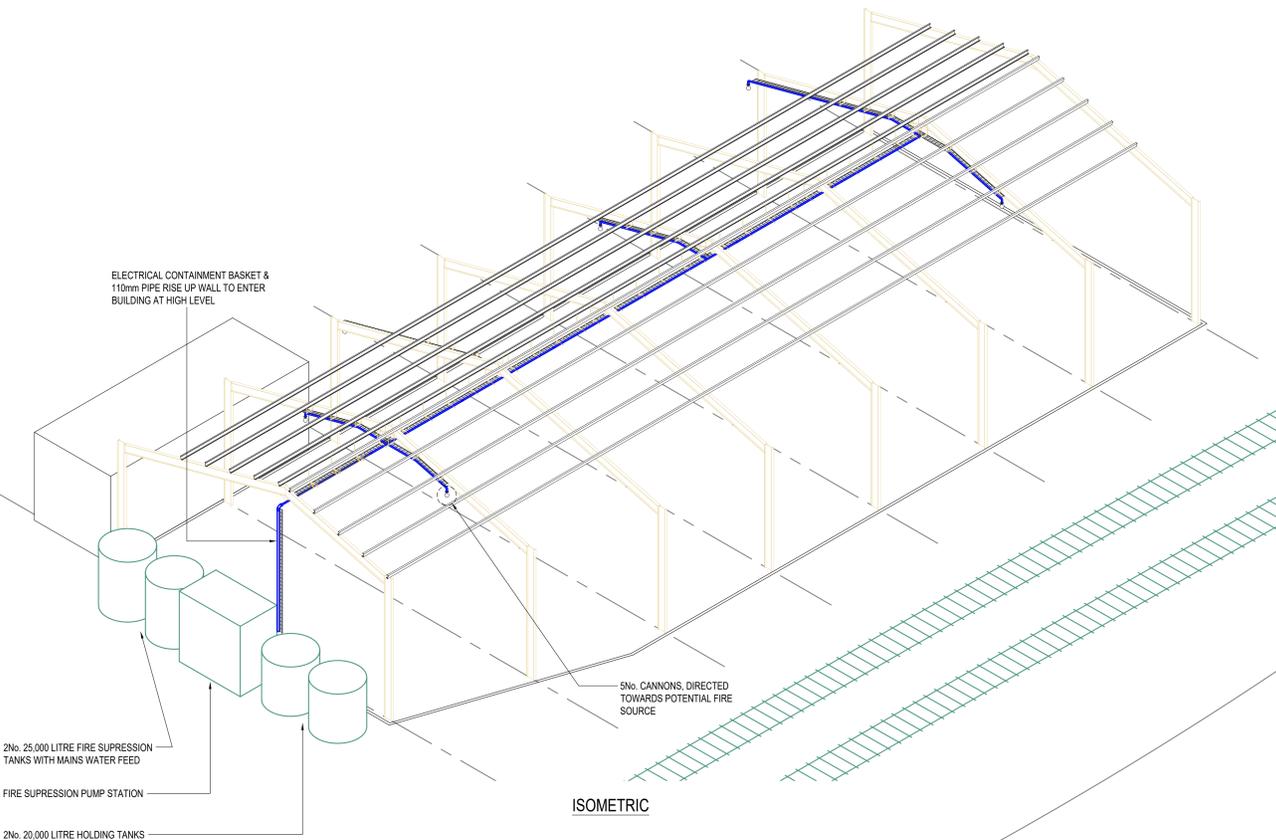

90mm FUSION PIPE

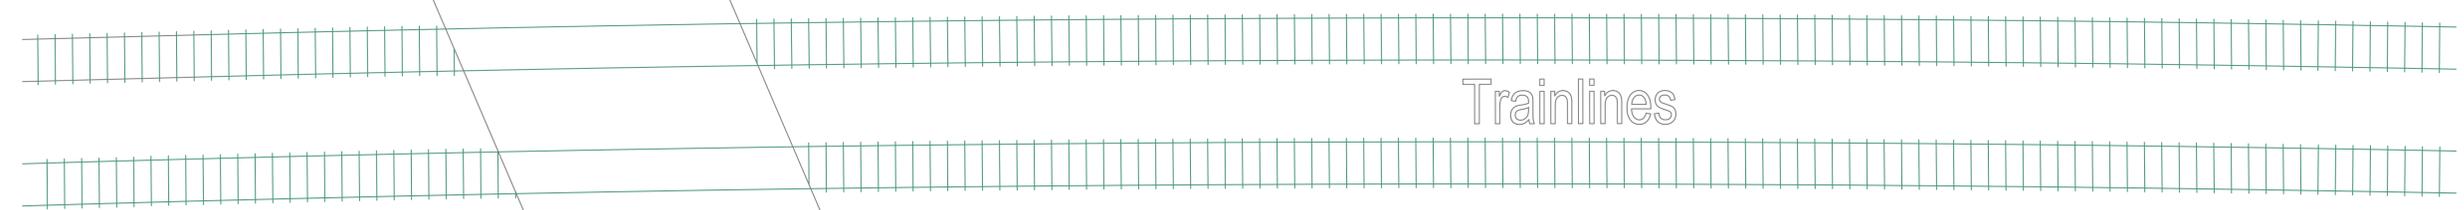

Warmetechnik Ltd.
 Unit 3
 Stockwood Business Park
 Stockwood
 Redditch
 B96 6SX
 United Kingdom

Dunn Brothers
 Fire Suppression System

AS BUILT RECORD COPY 27/06/2025