


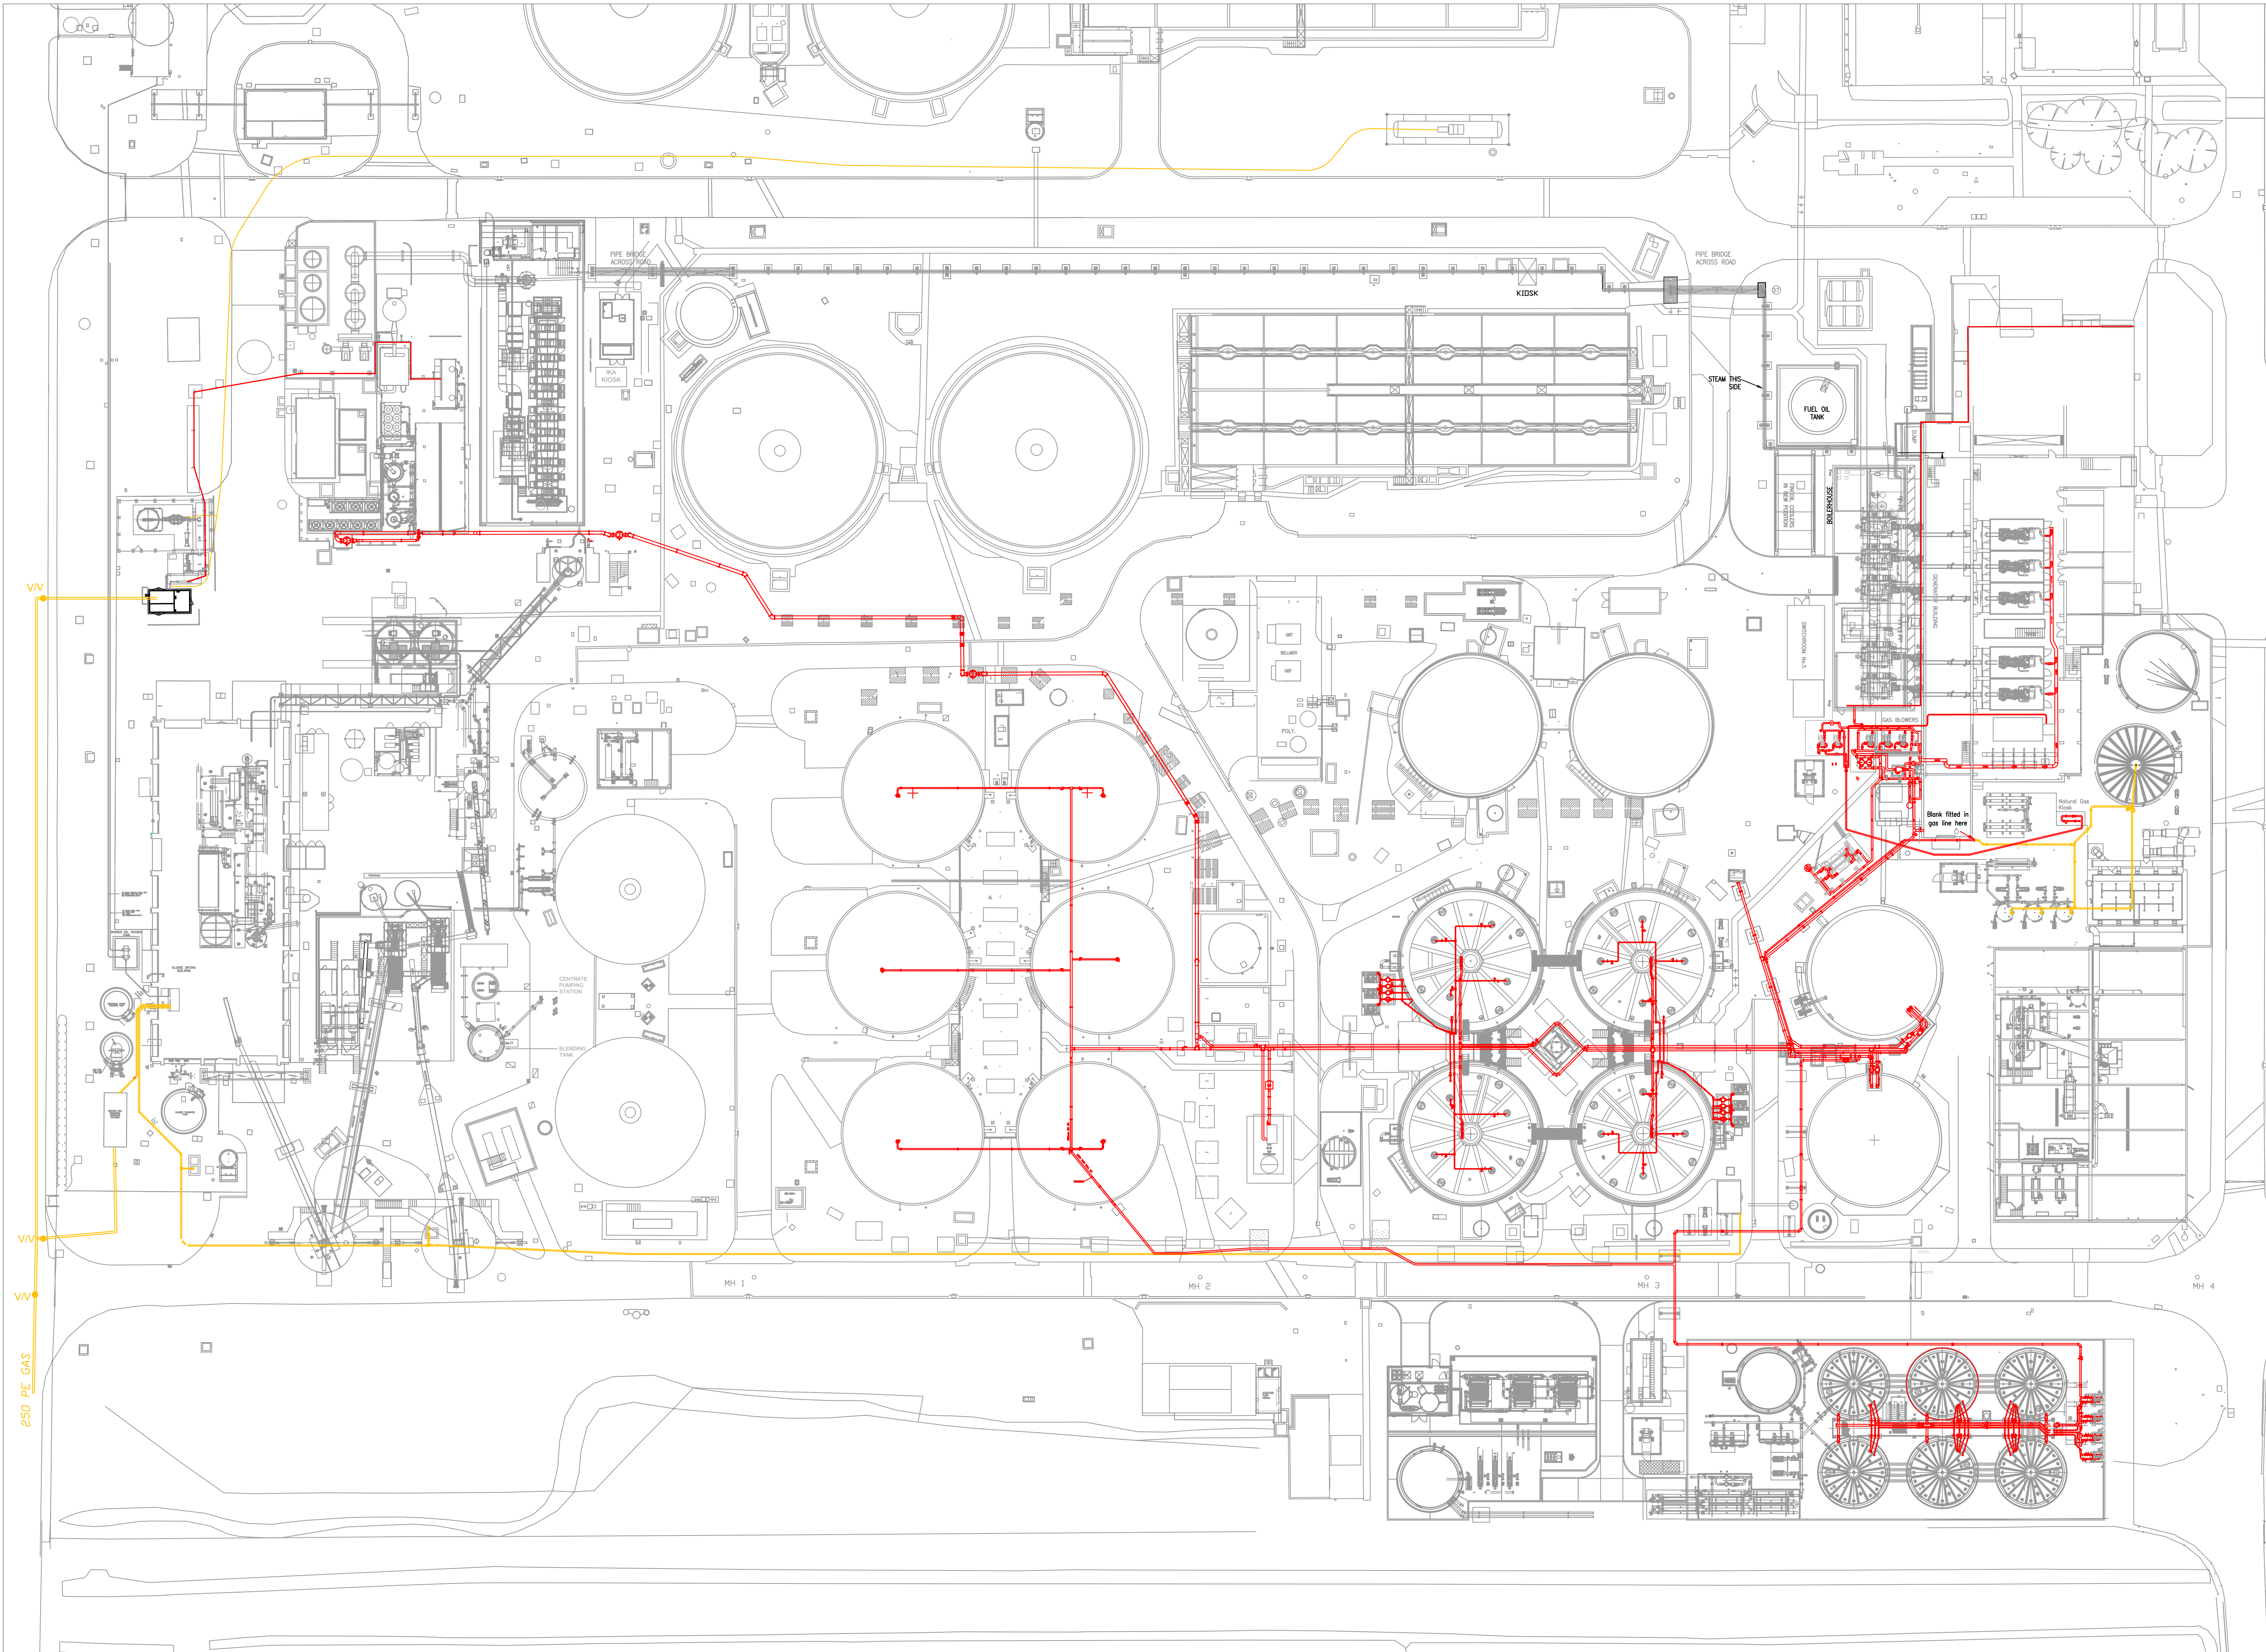

SITE ID
13013

SITE NAME
Avonmouth WWTW

NOTES
The pipelines shown on this drawing are taken from AS BUILT drawings. However some of the information may still be incorrect.

DATE
07/01/2019

DRAWING TITLE
Avonmouth WWTW
The gas pipework

SCALE
1:400

ORIGINAL DRAWING SIZE
A1

DRAWING ORIGINATOR
David Phillips.
Original Avonmouth services drawing by Carol Massey.