


Detail of Meadowgate Regulator

Sheffield Hadfields Flow Gauge

Discharge Point of Canklow Regulator



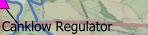


Woodhouse Mill Flow Gauge

Discharge Point of Meadowgate Regulator


Meadowgate Regulator





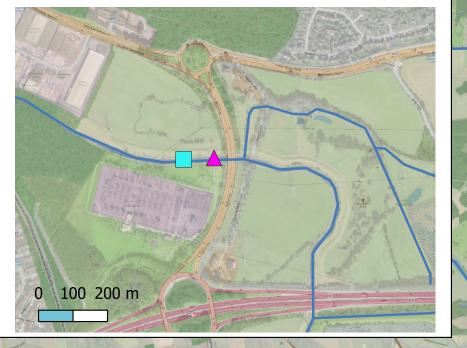



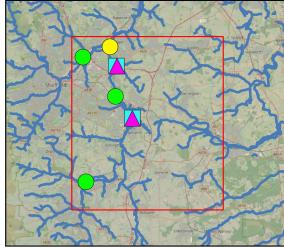

ENVIMNE790514-JBAB-00-00-DR-Z-1100-Plan_Drawing_Regulators_ &_Flow_Gauges

Plan of Don Regulators Points of Interest

Legend

- Oconfluence of River Rother and Don
- A Regulator Gates
 - Points of Discharge
- Flow Gauge Control Points
- ----- Watercourses


Drawn By:	SC	Date:	18/10/2023				
Checked By:	EG	Date:	19/10/2023				
Approved By:	ET	Date:	19/10/2023				
Status:	S1 Revision:P01						
Figure Title:	Plan Drawing						
File Name:	Z-1100		4-JBAB-00-00-DR- wing_Regulators_				




Contains OS data © Crown copyright and database right (2023)

www.jbaconsulting.com

 Figure 9-4 Meadowgate Regulator Location Plan

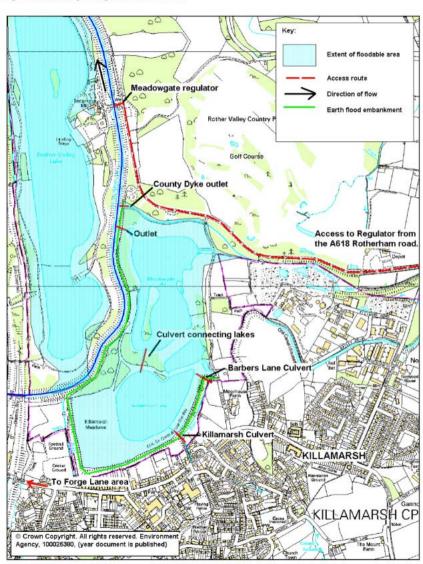




Detail of Meadowgate Regulator

Sheffield Hadfields Flow Gauge

Discharge Point of Canklow Regulator

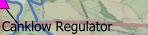




Woodhouse Mill Flow Gauge

Discharge Point of Meadowgate Regulator


Meadowgate Regulator





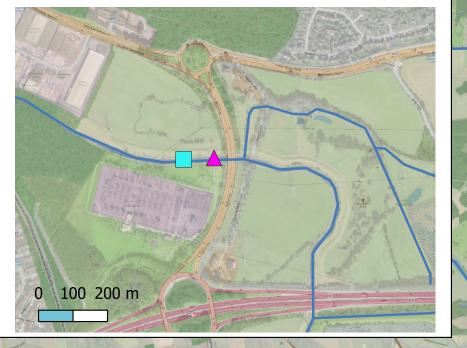



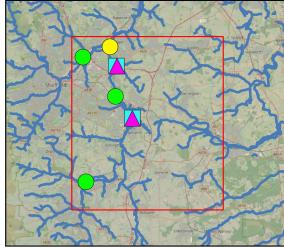

ENVIMNE790514-JBAB-00-00-DR-Z-1100-Plan_Drawing_Regulators_ &_Flow_Gauges

Plan of Don Regulators Points of Interest

Legend


- Oconfluence of River Rother and Don
- A Regulator Gates
 - Points of Discharge
- Flow Gauge Control Points
- ----- Watercourses

Drawn By:	SC	Date:	18/10/2023				
Checked By:	EG	Date:	19/10/2023				
Approved By:	ET	Date:	19/10/2023				
Status:	S1 Revision:P01						
Figure Title:	Plan Drawing						
File Name:	Z-1100		4-JBAB-00-00-DR- wing_Regulators_				



Contains OS data © Crown copyright and database right (2023)

www.jbaconsulting.com

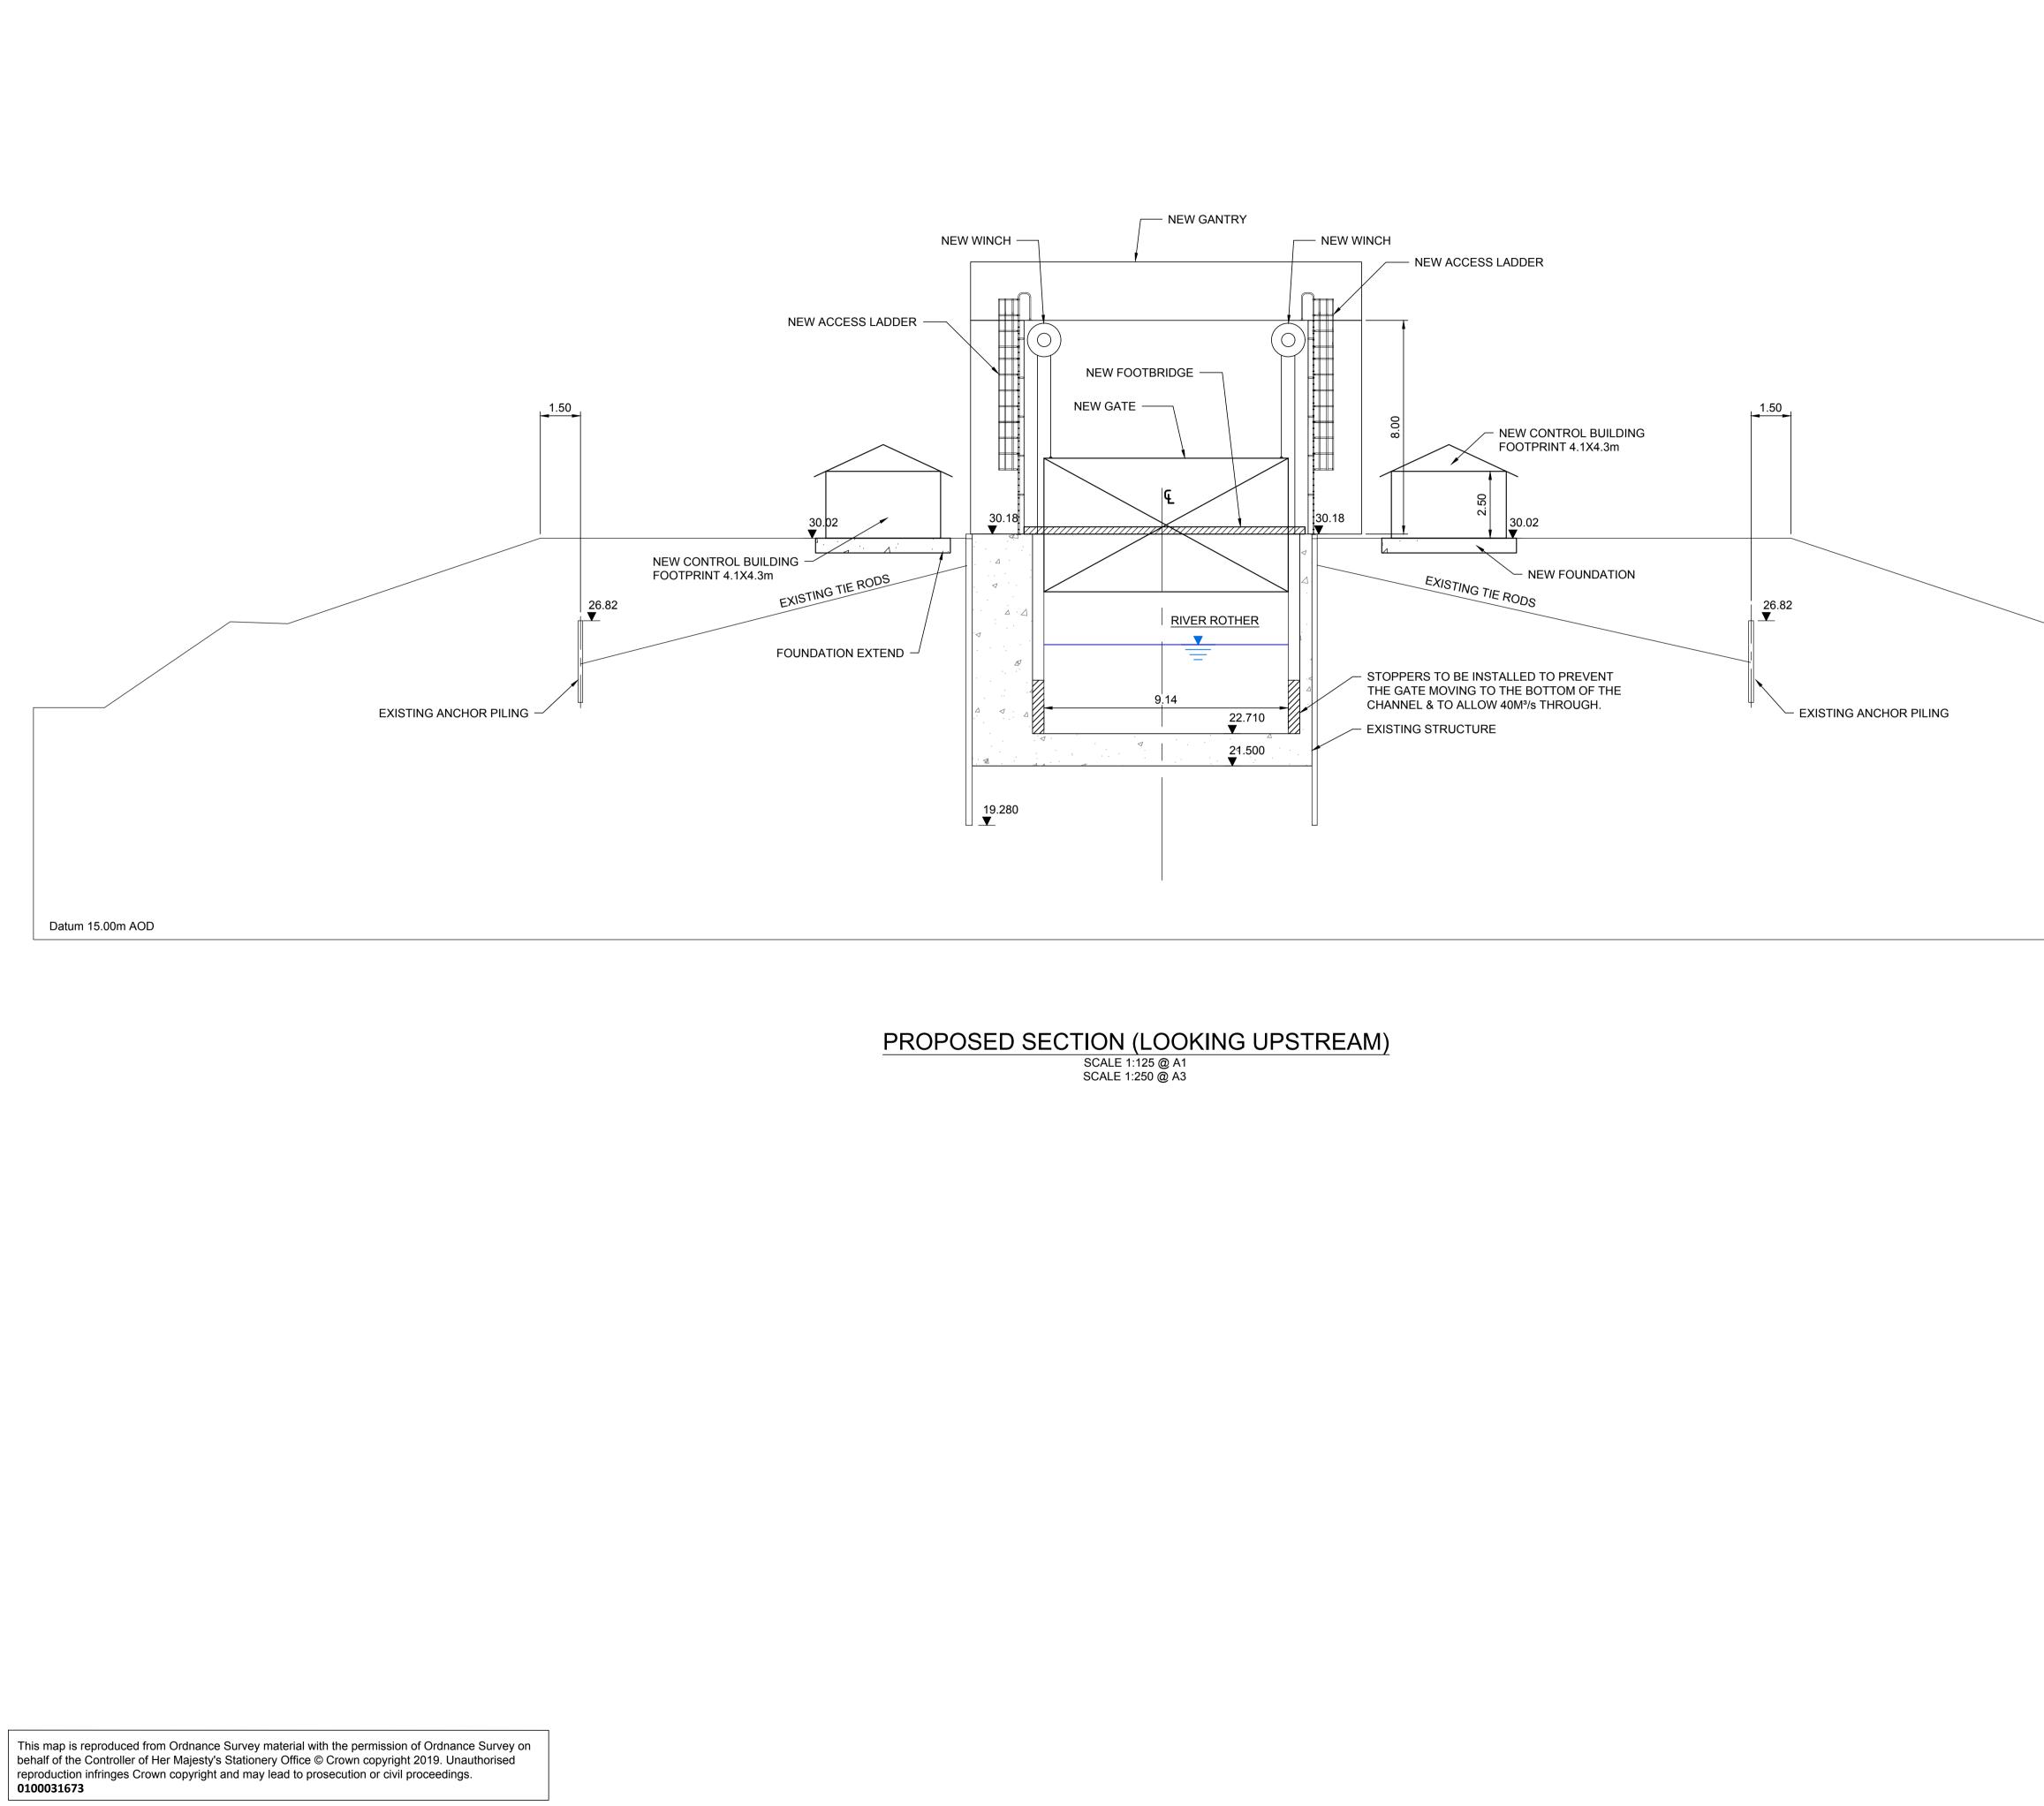


GENERAL NOTES


- 1. ALL DIMENSIONS ARE IN MILLIMETRES UNLESS NOTED OTHERWISE.
- 2. ALL LEVELS ARE IN METRES RELATIVE TO ORDNANCE DATUM NEWLYN (OD) UNLESS NOTED OTHERWISE.
- 3. ALL COORDINATES ARE IN METRES RELATIVE TO ORDNANCE SURVEY NATIONAL GRID. 4. DO NOT SCALE FROM THIS DRAWING. ALL DIMENSIONS MUST BE
- CHECKED/VERIFIED ON SITE.
- 5. ANY DISCREPANCIES NOTED ON SITE ARE TO BE REPORTED TO THE SUPERVISOR IMMEDIATELY.
- 6. THE ELECTRONIC VERSION OF THIS DRAWING IS NOT TO BE USED FOR SETTING OUT.

BASED ON HISTORICAL DRAWING DO NOT SCALE

C01	First issue	18	8/07/19	DP	AP	SC	SC			
Rev.	Description		Date	Drawn	rawn Designed Checked Approve					
	SUITABLE	FOR C	ONC	ЕРТ І	DESIG	N				
J	BA Be	entle	y 🏌	2	5th Floor, Sta The Bouleva Clarence Do LEEDS LS10 1PZ T +44 (0)113 E info@jba-t www.jba-ber	rd ck 3 245 2528 pentley.co	3 .uk			
Project:	on Regulato	ors Ou	tline	Bus	iness	Ca	se			
Title:										
	Don Re	Can	clov	V	tures					
	Don Re	Can		V	tures					
	Don Re	Can Sec	clov	V	tures					
Client:	Don Re	Can Sec	clow clow ction	V		t				
This doc	Don Re	Can Sec fr Env Age	clow ction or	onn y	nen		r disclosed			
This doc	ument is the property of JBA-B	Can Sec fr Env Age		onn y	nen		r disclosed 25/06/19			
This doc to a third	ument is the property of JBA-B d party, without the permission D PSTRAGOWSKA	Can Sec for Env Age	clow tion or	y Dun y reproduced	nen I in whole or OLLARD					
This doc to a third Drawn: Checked	ument is the property of JBA-B party, without the permission D PSTRAGOWSKA	Can Sec for Env Age	clow tion or	reproduced ned: A Proved: S C	nen I in whole or OLLARD		25/06/19			
This doc to a third Drawn: Checked Project F	ument is the property of JBA-B d party, without the permission D PSTRAGOWSKA d: S CROPLEY	Can Sec for Env Age	clow ction or	reproduced ned: A Proved: S C	I in whole or OLLARD ROPLEY	in part, no	25/06/19			

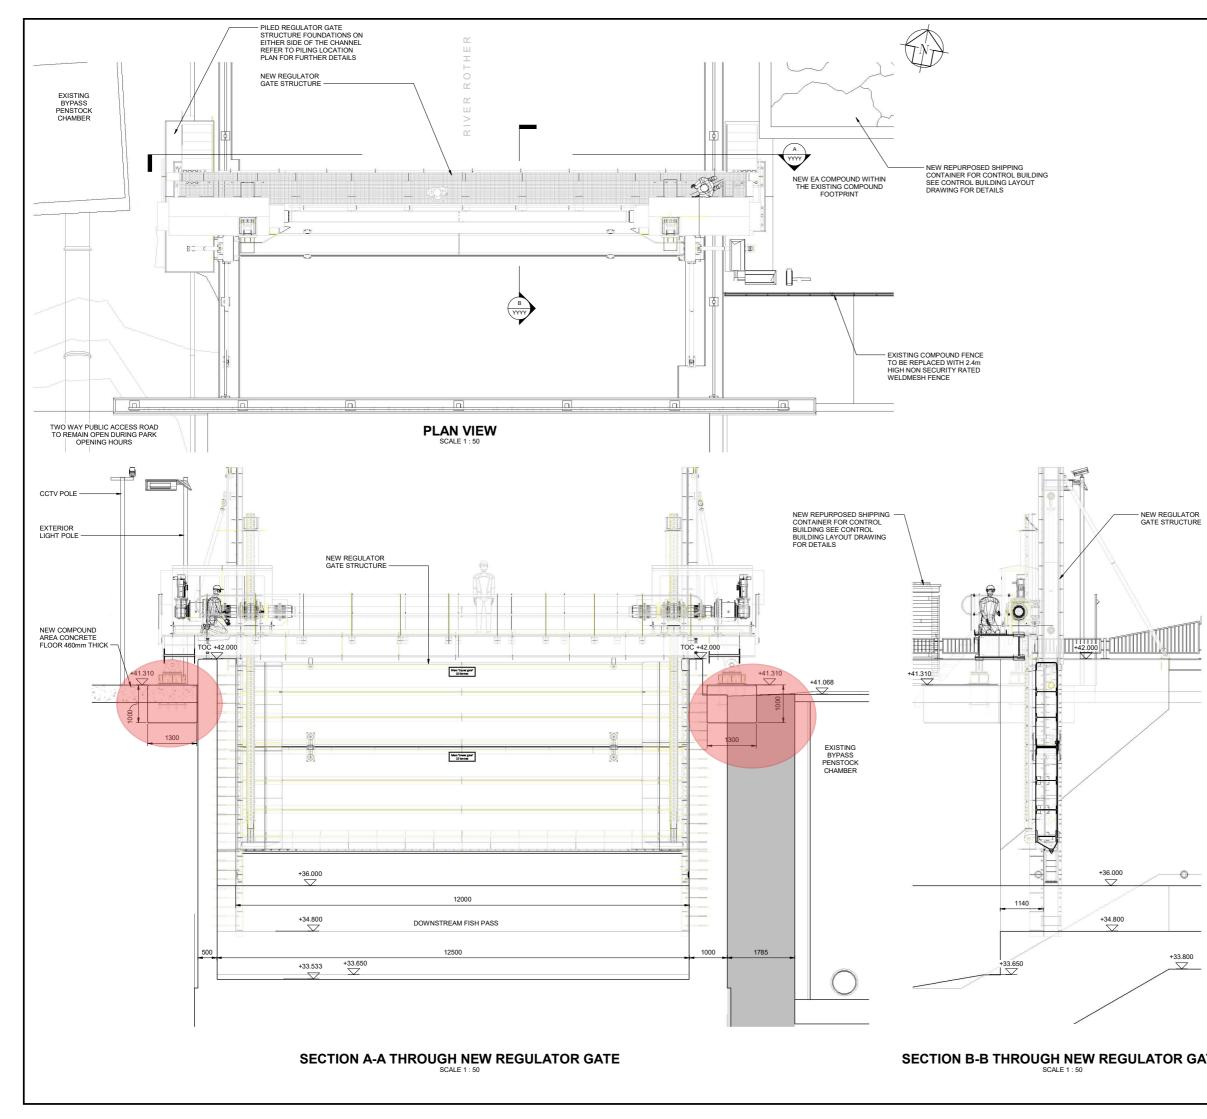

	GENERAL NOT	TES		
	ALL LEVELS ARE	S ARE IN MILLIMETRE E IN METRES RELATIV	S UNLESS NOTED OT E TO ORDNANCE DA	HERWISE. TUM NEWLYN (mAOD)
	UNLESS NOTED 3. ALL COORDINAT	OTHERWISE.		
		FROM THIS DRAWING	. ALL DIMENSIONS M	UST BE CHECKED /
	5. JNB CONSTRUC	TE. TION COMPOUND TO	BE LOCATED IN PARI	K OVERFLOW CAR
	FOR EXISTING S	T TO THE CONSTRUC SERVICES REFER TO		
	JBAB-00-4_03-DF	R-C-0001-Meadowgate_	Hazard_Plan	
	D01 51007 1001		05/01/00	
	P01 FIRST ISSUE		05/01/22 PE	_
	Rev. Description Document Control		Date Author De:	signer Checker Approver
	Project Title			
		OWGATE D		
		ROTHER VA		
	Drawing Title			
				
	NEW REG	ULATOR G	ATE ARRA	NGEMENT
		-	•	
		Env	vironme	ent
		Δ σe	ency	
	© copyright reserved	A rage	JIIC y	
	Parent Model			
	Security Classification		Scale	
	OFFICIAL			
	Author P.ETHERINGTON	Designer Designer	Checker Checker	Approver Approver
TE	Suitability	IL	IL	Status Revision
	WORK IN PROGRESS	3		S0 P01
	Information Container IMNE790514-JBAB-ZZ	Z-4 03-DR-C-YYYY		A1 Sheet Size

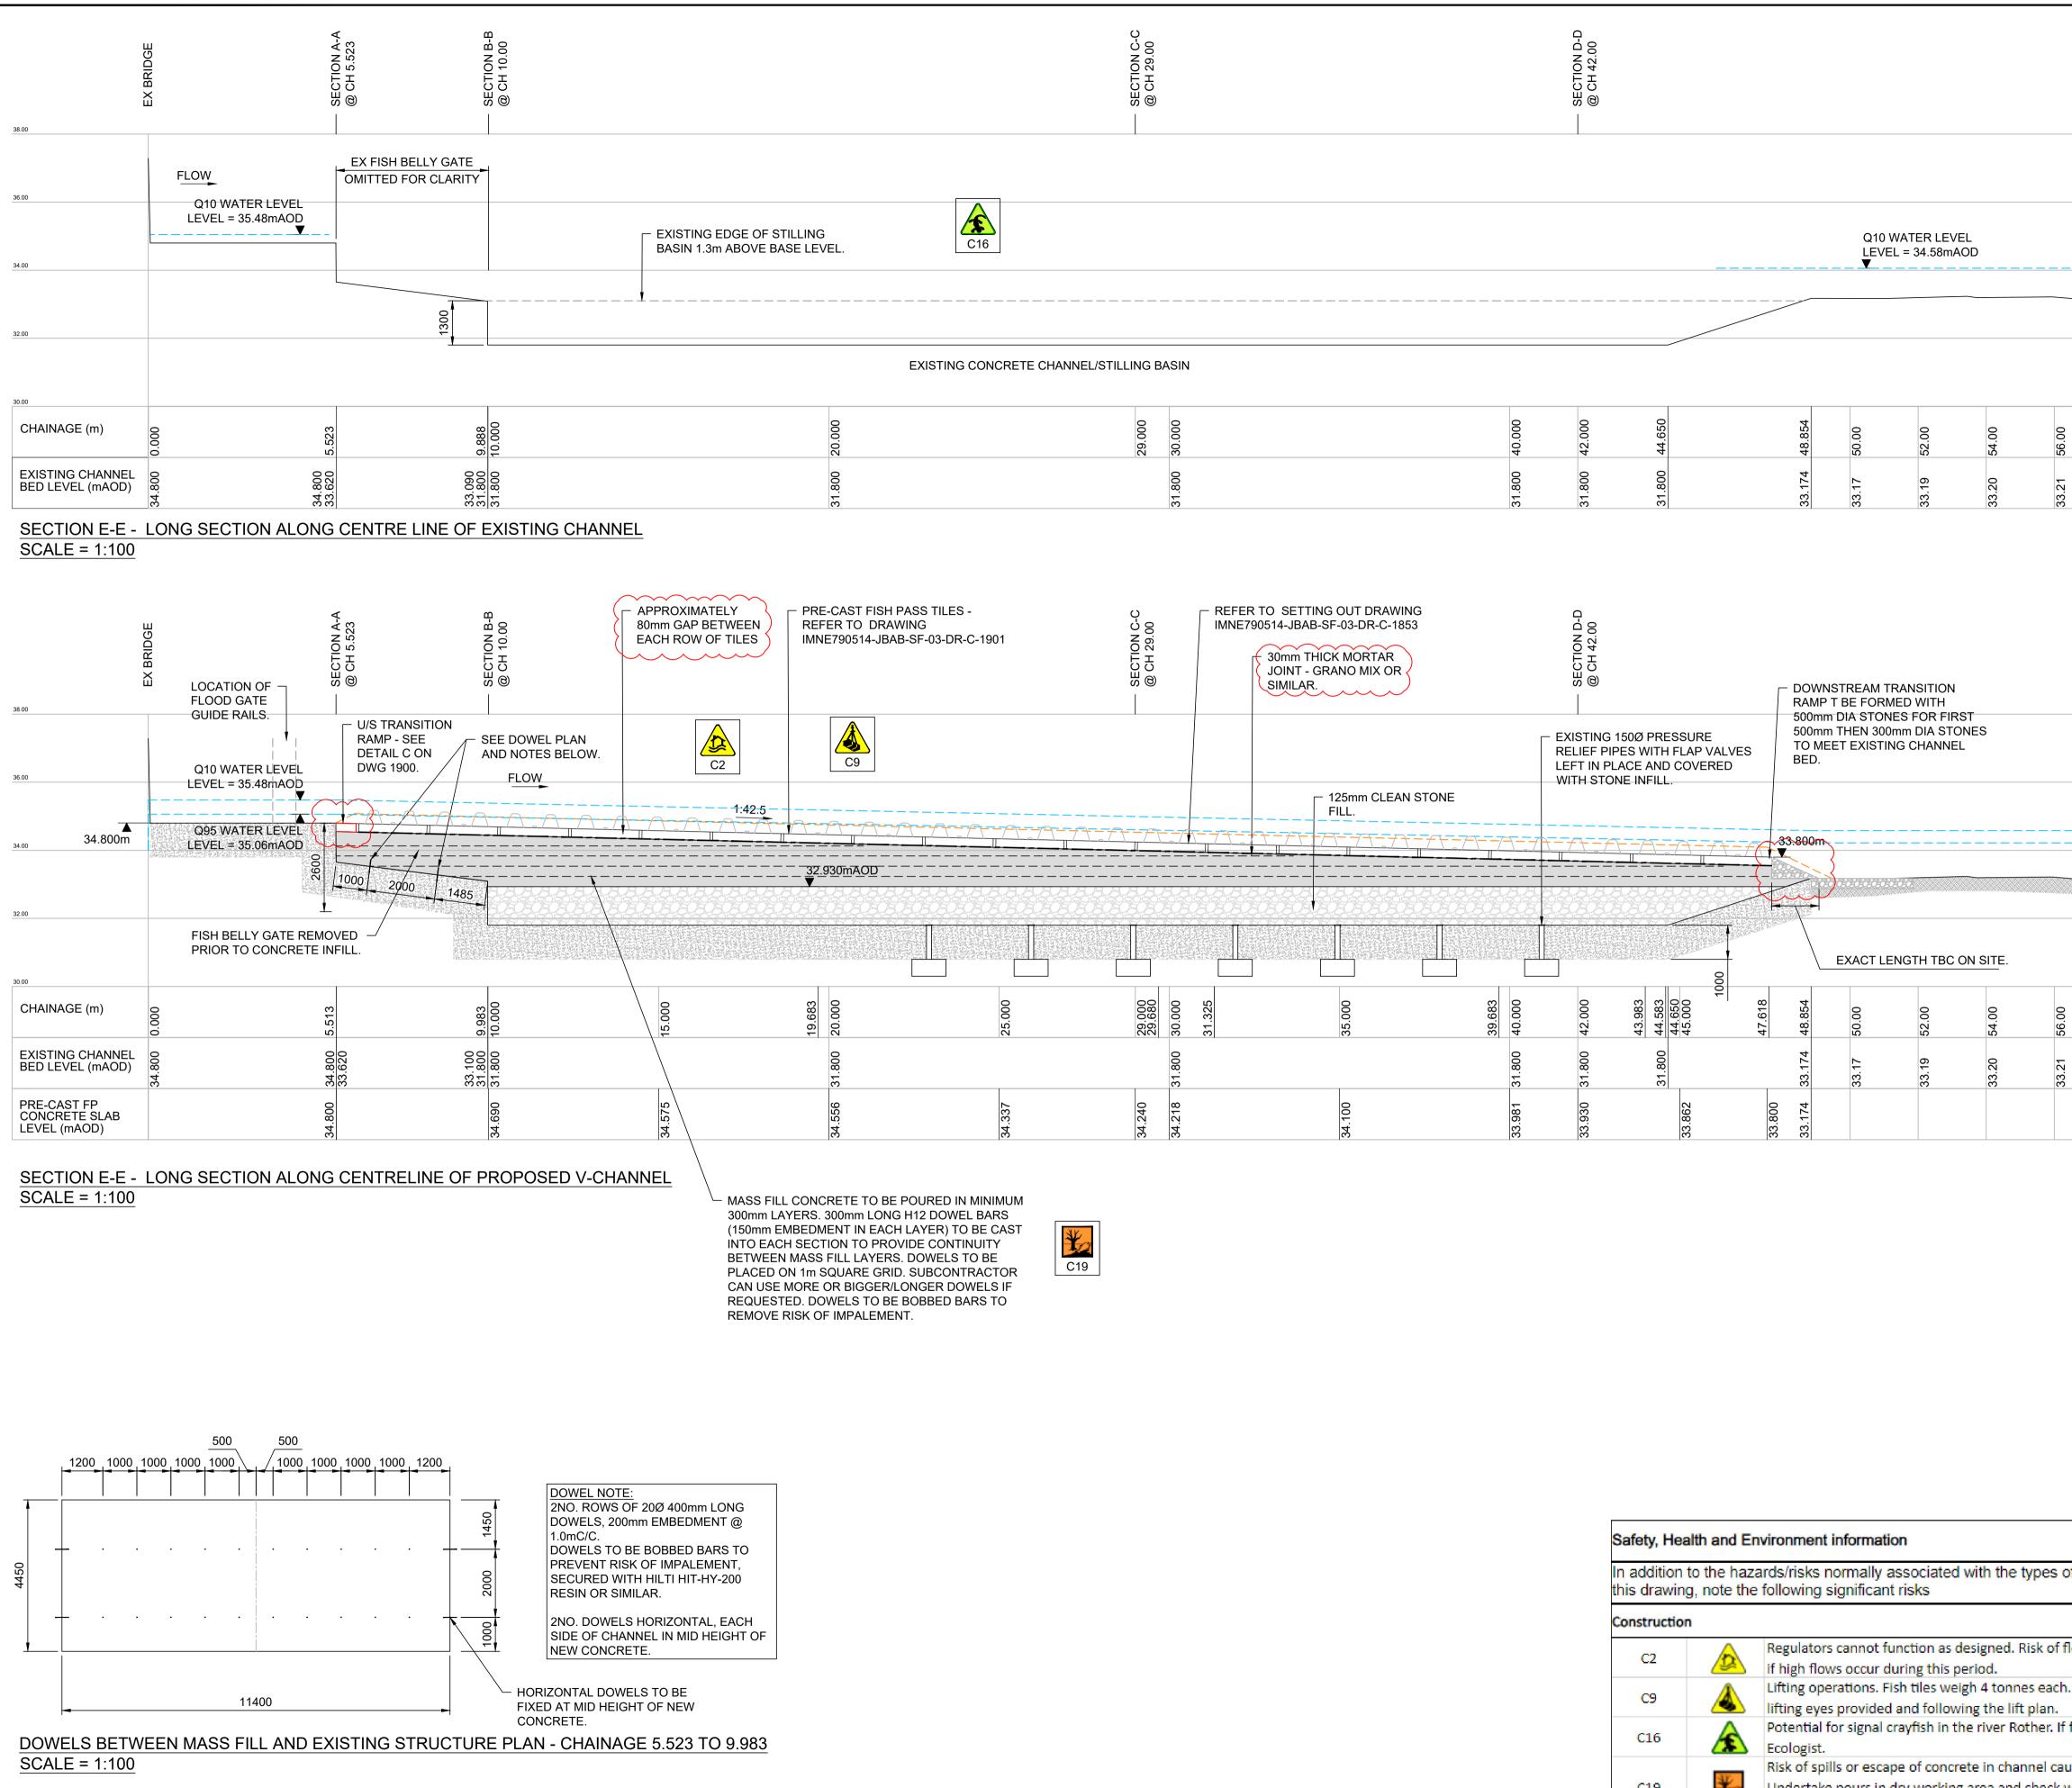





29.000	40.000	42.000	44.650	48.854	50.00	52.00	54.00	56.00
31.800	31.800	31.800	31.800	33.174	33.17	33.19	33.20	33.21

		ards/risks normally associated with the types of following significant risks
Construction	n	
C2		Regulators cannot function as designed. Risk of flait flags
C9	▲	Lifting operations. Fish tiles weigh 4 tonnes each. lifting eyes provided and following the lift plan.
C16	Â	Potential for signal crayfish in the river Rother. If f Ecologist.
C19	影	Risk of spills or escape of concrete in channel cau Undertake pours in dry working area and check w
Inspection/n	naintenanco	rain and river levels prior to pouring.
Decommissi	oning / Den	nolition

1. A 2. A (r 3. A	RAL NOTES						
(r 3. A		S ARE IN MILLIMETRE					
	mAOD) UNLESS	IN METRES RELATIV NOTED OTHERWISE.					
I IN	LL COORDINAT	ES ARE IN METRES R	RELATIVE		NANCE S	URVEY	
	O NOT SCALE F ERIFIED ON SIT	ROM THIS DRAWING	. ALL DIME	INSION	S MUST B	E CHEC	KED /
5. A	NY DISCREPAN	ICIES NOTED ON SITE	E ARE TO E	BE REP	ORTED TO	O THE	
6. T		DIATELY. C VERSION OF THIS [DRAWING	IS NOT	TO BE US	ED FOR	
	ETTING OUT						
DRAW	VING TO BE REA		WITH THE	FOLLO	WING DRA	WINGS:	
		-03-DR-C-1700-FISH_I -03-DR-C-1851-FISH_I				MENT_PL	AN
IMNE7	790514-JBAB-SF	-03-DR-C-1900-FISH_I	PASS_CON	ISTRUC	CTION_DE	TAILS	
IMNE7	790514-JBAB-SF	-03-DR-C-1600-FISH_F -03-DR-Z-0038-KEY_H	IAZARDS_I	PLAN	'LAN		
IMNE7	790514-JBAB-SF	-4_03-DR-C-1853-FISH -03-DR-C-1901-FISH_F	I_PASS_S	OPs		DRAWIN	G
	EVIATIONS:		·· - -				
ToC =	TOP OF CONCI	RETE					
DH = [DOWEL HOLE						
PR = F	PRESSURE REL	IEF HULE					
	-	0 0	-				,
	5m 4	3 2 1 0	2		4	6m	
	5m 4		2 E 1:100		4	6m	
		SCAL	E 1:100				
C02.1				AB	4 ET	6m ET	СТ
C02.1 CO1.1	TOP TRANSI	SCAL	E 1:100				СТ
	TOP TRANSI	SCAL TION RAMP REVISED	E 1:100	AB	ET	ET	
CO1.1 P01.4	TOP TRANSI FOR CO MAIN SLOPE	SCAL TION RAMP REVISED ONSTRUCTION GRADIENT AMENDED	E 1:100 11.07.23 07.06.23 30.03.23	AB AB AB	ET DP AB	ET ET DR	СТ
CO1.1	TOP TRANSI FOR CO MAIN SLOPE	SCAL TION RAMP REVISED	E 1:100 11.07.23 07.06.23	AB AB	ET	ET	СТ
CO1.1 P01.4	TOP TRANSI FOR CO MAIN SLOPE PRESSURE F	SCAL TION RAMP REVISED ONSTRUCTION GRADIENT AMENDED	E 1:100 11.07.23 07.06.23 30.03.23	AB AB AB	ET DP AB	ET ET DR	СТ
CO1.1 P01.4 P01.3	TOP TRANSI FOR CO MAIN SLOPE PRESSURE F FILL MAT	SCAL TION RAMP REVISED ONSTRUCTION GRADIENT AMENDED RELIEF PIPES ADDED	E 1:100 11.07.23 07.06.23 30.03.23 09.12.22	AB AB AB AB	ET DP AB AB	ET ET DR	СТ
CO1.1 P01.4 P01.3 P01.2 PO1.1	TOP TRANSI FOR C MAIN SLOPE PRESSURE F FILL MAT PRELIMINA	SCAL TION RAMP REVISED ONSTRUCTION GRADIENT AMENDED RELIEF PIPES ADDED TERIAL CHANGE	E 1:100 11.07.23 07.06.23 30.03.23 09.12.22 25.11.22 20.10.22	AB AB AB AB AB AB	ET DP AB AB AB AB AB	ET ET DR DR	СТСТСТ
CO1.1 P01.4 P01.3 P01.2 PO1.1 Rev.	TOP TRANSI FOR CO MAIN SLOPE PRESSURE F FILL MAT	SCAL TION RAMP REVISED ONSTRUCTION GRADIENT AMENDED RELIEF PIPES ADDED TERIAL CHANGE	E 1:100 11.07.23 07.06.23 30.03.23 09.12.22 25.11.22	AB AB AB AB AB	ET DP AB AB AB	ET ET DR	СТ
CO1.1 P01.4 P01.3 P01.2 PO1.1 Rev. Docume	TOP TRANSI FOR CO MAIN SLOPE PRESSURE F FILL MAT PRELIMINA Description nt Control	SCAL TION RAMP REVISED ONSTRUCTION GRADIENT AMENDED RELIEF PIPES ADDED TERIAL CHANGE	E 1:100 11.07.23 07.06.23 30.03.23 09.12.22 25.11.22 20.10.22	AB AB AB AB AB AB Author	ET DP AB AB AB AB AB AB Designer	ET ET DR DR	СТСТСТ
CO1.1 P01.4 P01.3 P01.2 PO1.1 Rev.	TOP TRANSI FOR CO MAIN SLOPE PRESSURE F FILL MAT PRELIMINA Description nt Control	SCAL TION RAMP REVISED ONSTRUCTION GRADIENT AMENDED RELIEF PIPES ADDED TERIAL CHANGE	E 1:100 11.07.23 07.06.23 30.03.23 09.12.22 25.11.22 20.10.22	AB AB AB AB AB AB Author	ET DP AB AB AB AB AB Designer	ET DR DR Checker	СТСТСТ
CO1.1 P01.4 P01.3 P01.2 PO1.1 Rev. Documen	TOP TRANSI FOR CO MAIN SLOPE PRESSURE F FILL MAT PRELIMINA Description nt Control	SCAL TION RAMP REVISED ONSTRUCTION GRADIENT AMENDED RELIEF PIPES ADDED TERIAL CHANGE	E 1:100 11.07.23 07.06.23 30.03.23 09.12.22 25.11.22 20.10.22 Date	AB AB AB AB AB AB AUthor	ET DP AB AB AB AB AB Designer	ET DR DR Checker	СТСТСТ
CO1.1 P01.4 P01.3 P01.2 PO1.1 Rev. Documen	TOP TRANSI FOR CO MAIN SLOPE PRESSURE F FILL MAT PRELIMINA Description nt Control	SCAL TION RAMP REVISED ONSTRUCTION GRADIENT AMENDED RELIEF PIPES ADDED TERIAL CHANGE RY DESIGN STAGE	E 1:100 11.07.23 07.06.23 30.03.23 09.12.22 25.11.22 20.10.22 Date	AB AB AB AB AB AB AUthor	ET DP AB AB AB AB AB Designer st Floor, ank House, 7 King Street, eeds, S1 2HL +44 (0)113 4	ET ET DR DR Checker	СТСТСТ
CO1.1 P01.4 P01.3 P01.2 PO1.1 Rev. Documen	TOP TRANSI FOR CO MAIN SLOPE PRESSURE F FILL MAT PRELIMINA Description nt Control	SCAL TION RAMP REVISED ONSTRUCTION GRADIENT AMENDED RELIEF PIPES ADDED TERIAL CHANGE RY DESIGN STAGE	E 1:100 11.07.23 07.06.23 30.03.23 09.12.22 25.11.22 20.10.22 Date	AB AB AB AB AB AB AUthor	ET DP AB AB AB AB AB Designer st Floor, ank House, 7 King Street, eeds, S1 2HL	ET ET DR DR Checker	СТСТСТ
CO1.1 P01.4 P01.3 P01.2 PO1.1 Rev. Documen	TOP TRANSI FOR CO MAIN SLOPE PRESSURE F FILL MAT PRELIMINA Description nt Control	SCAL TION RAMP REVISED ONSTRUCTION GRADIENT AMENDED RELIEF PIPES ADDED TERIAL CHANGE RY DESIGN STAGE	E 1:100 11.07.23 07.06.23 30.03.23 09.12.22 25.11.22 20.10.22 Date	AB AB AB AB AB AB AUthor	ET DP AB AB AB AB AB Designer st Floor, ank House, 7 King Street, eeds, S1 2HL +44 (0)113 4 info@jba-ber	ET ET DR DR Checker	СТСТСТ
CO1.1 P01.4 P01.3 P01.2 PO1.1 Rev. Documen Supplier	TOP TRANSI FOR CO MAIN SLOPE PRESSURE F FILL MAT PRELIMINA Description nt Control	SCAL TION RAMP REVISED ONSTRUCTION GRADIENT AMENDED RELIEF PIPES ADDED TERIAL CHANGE RY DESIGN STAGE Bentl	E 1:100 11.07.23 07.06.23 30.03.23 09.12.22 25.11.22 20.10.22 Date	AB AB AB AB AB AB AUthor 11 B 22 L4 L4 L4 L4 L4 L4 L4 L4 L4 L4 L4 L4 L4	ET DP AB AB AB AB AB Designer st Floor, ank House, 7 King Street, eeds, S1 2HL +44 (0)113 4 info@jba-bentle	ET DR DR DR Checker	CT CT CT Approver
CO1.1 P01.4 P01.3 P01.2 PO1.1 Rev. Documen Supplier	TOP TRANSI FOR CO MAIN SLOPE PRESSURE F FILL MAT PRELIMINA Description nt Control	SCAL TION RAMP REVISED ONSTRUCTION GRADIENT AMENDED RELIEF PIPES ADDED TERIAL CHANGE RY DESIGN STAGE	E 1:100 11.07.23 07.06.23 30.03.23 09.12.22 25.11.22 20.10.22 Date	AB AB AB AB AB AB AUthor 11 B 22 L4 L4 L4 L4 L4 L4 L4 L4 L4 L4 L4 L4 L4	ET DP AB AB AB AB AB Designer st Floor, ank House, 7 King Street, eeds, S1 2HL +44 (0)113 4 info@jba-bentle	ET DR DR DR Checker	CT CT CT Approver
CO1.1 P01.4 P01.3 P01.2 PO1.1 Rev. Documen Supplier	TOP TRANSI FOR CO MAIN SLOPE PRESSURE F FILL MAT PRELIMINA Description nt Control	SCAL TION RAMP REVISED ONSTRUCTION GRADIENT AMENDED RELIEF PIPES ADDED TERIAL CHANGE RY DESIGN STAGE Bentl	E 1:100 11.07.23 07.06.23 30.03.23 09.12.22 25.11.22 20.10.22 Date	AB AB AB AB AB AB AUthor 11 B 22 L4 L4 L4 L4 L4 L4 L4 L4 L4 L4 L4 L4 L4	ET DP AB AB AB AB AB Designer st Floor, ank House, 7 King Street, eeds, S1 2HL +44 (0)113 4 info@jba-bentle	ET DR DR DR Checker	CT CT CT Approver
CO1.1 P01.4 P01.3 P01.2 PO1.1 Rev. Documen	TOP TRANSI FOR CO MAIN SLOPE PRESSURE F FILL MAT PRELIMINA Description nt Control	SCAL TION RAMP REVISED ONSTRUCTION GRADIENT AMENDED RELIEF PIPES ADDED TERIAL CHANGE RY DESIGN STAGE Bentl	E 1:100 11.07.23 07.06.23 30.03.23 09.12.22 25.11.22 20.10.22 Date	AB AB AB AB AB AB AUthor 11 B 22 L4 L4 L4 L4 L4 L4 L4 L4 L4 L4 L4 L4 L4	ET DP AB AB AB AB AB Designer st Floor, ank House, 7 King Street, eeds, S1 2HL +44 (0)113 4 info@jba-bentle	ET DR DR DR Checker	CT CT CT Approver
CO1.1 P01.4 P01.3 P01.2 PO1.1 Rev. Documen	TOP TRANSI FOR CO MAIN SLOPE PRESSURE F FILL MAT PRELIMINA Description nt Control	SCAL TION RAMP REVISED ONSTRUCTION GRADIENT AMENDED TERIAL CHANGE RY DESIGN STAGE Bentl EGULATOR	E 1:100 11.07.23 07.06.23 09.12.22 25.11.22 20.10.22 Date CS - M	AB AB AB AB AB AUthor 11 B 2 Lu Lu Lu Lu Lu Lu Lu Lu Lu Lu Lu Lu Lu	ET DP AB AB AB AB Designer St Floor, ank House, 7 King Street, eeds, S1 2HL +44 (0)113 4 info@jba-bentle ww.jba-bentle	ET ET DR DR Checker	CT CT CT Approver
CO1.1 P01.4 P01.3 P01.2 PO1.1 Rev. Documen Supplier	TOP TRANSI FOR CO MAIN SLOPE PRESSURE F FILL MAT PRELIMINA Description nt Control	SCAL TION RAMP REVISED ONSTRUCTION GRADIENT AMENDED RELIEF PIPES ADDED TERIAL CHANGE RY DESIGN STAGE Bentl	E 1:100 11.07.23 07.06.23 09.12.22 25.11.22 20.10.22 Date C	AB AB AB AB AB AUthor 11 B 2 Lu Lu Lu Lu Lu Lu Lu Lu Lu Lu Lu Lu Lu	ET DP AB AB AB AB Designer St Floor, ank House, 7 King Street, eeds, S1 2HL +44 (0)113 4 info@jba-bentle ww.jba-bentle	ET ET DR DR Checker	CT CT CT Approver
CO1.1 P01.4 P01.3 P01.2 PO1.1 Rev. Documen	TOP TRANSI FOR CO MAIN SLOPE PRESSURE F FILL MAT PRELIMINA Description nt Control	SCAL TION RAMP REVISED ONSTRUCTION GRADIENT AMENDED TERIAL CHANGE RY DESIGN STAGE Bentl EGULATOR	E 1:100 11.07.23 07.06.23 09.12.22 25.11.22 20.10.22 Date CS - M	AB AB AB AB AB AB AB AUthor I I I I I I I I I I I I I I I I I I I	ET DP AB AB AB AB AB Designer st Floor, ank House, 7 King Street, eeds, S1 2HL +44 (0)113 4 info@jba-ber ww.jba-bentle DOW(ET ET DR DR Checker	CT CT CT Approver
CO1.1 P01.4 P01.3 P01.2 PO1.1 Rev. Documen Supplier	TOP TRANSI FOR CO MAIN SLOPE PRESSURE F FILL MAT PRELIMINA Description nt Control	SCAL TION RAMP REVISED ONSTRUCTION GRADIENT AMENDED RELIEF PIPES ADDED TERIAL CHANGE RY DESIGN STAGE Bentle EGULATOR	E 1:100 11.07.23 07.06.23 09.12.22 25.11.22 20.10.22 Date CS - M	AB AB AB AB AB AB AB AUthor I I I I I I I I I I I I I I I I I I I	ET DP AB AB AB AB AB Designer st Floor, ank House, 7 King Street, eeds, S1 2HL +44 (0)113 4 info@jba-ber ww.jba-bentle DOW(ET ET DR DR Checker	CT CT CT Approver
CO1.1 P01.4 P01.3 P01.2 PO1.1 Rev. Documen Supplier	TOP TRANSI FOR CO MAIN SLOPE PRESSURE F FILL MAT PRELIMINA Description nt Control	SCAL TION RAMP REVISED ONSTRUCTION GRADIENT AMENDED RELIEF PIPES ADDED TERIAL CHANGE RY DESIGN STAGE Bentle EGULATOR	E 1:100 11.07.23 07.06.23 09.12.22 25.11.22 20.10.22 Date CS - M	AB AB AB AB AB AB AB AUthor I I I I I I I I I I I I I I I I I I I	ET DP AB AB AB AB AB Designer st Floor, ank House, 7 King Street, eeds, S1 2HL +44 (0)113 4 info@jba-ber ww.jba-bentle DOW(ET ET DR DR Checker	CT CT CT Approver
CO1.1 P01.4 P01.3 P01.2 PO1.1 Rev. Documen Supplier	TOP TRANSI FOR CO MAIN SLOPE PRESSURE F FILL MAT PRELIMINA Description nt Control	SCAL TION RAMP REVISED ONSTRUCTION GRADIENT AMENDED RELIEF PIPES ADDED TERIAL CHANGE RY DESIGN STAGE Bentl Bentl EGULATOR EGULATOR	E 1:100 11.07.23 07.06.23 09.12.22 25.11.22 20.10.22 Date CS - M CE FIS	AB AB AB AB AB AB AB AUthor It B 2 Lu Li Li Li Li Li Li Li Li Li Li Li Li Li	ET DP AB AB AB AB Designer St Floor, ank House, 7 King Street, eeds, S1 2HL +44 (0)113 4 info@jba-ber +44 (0)113 4 info@jba-bertle	ET DR DR DR Checker	CT CT CT Approver
CO1.1 P01.4 P01.3 P01.2 PO1.1 Rev. Document Supplier	TOP TRANSI FOR CO MAIN SLOPE PRESSURE F FILL MAT PRELIMINA Description nt Control	SCAL TION RAMP REVISED ONSTRUCTION GRADIENT AMENDED RELIEF PIPES ADDED TERIAL CHANGE RY DESIGN STAGE Bentle EGULATOR	E 1:100 11.07.23 07.06.23 09.12.22 25.11.22 20.10.22 Date CS - M CE FIS	AB AB AB AB AB AB AB AUthor It B 2 Lu Li Li Li Li Li Li Li Li Li Li Li Li Li	ET DP AB AB AB AB Designer St Floor, ank House, 7 King Street, eeds, S1 2HL +44 (0)113 4 info@jba-ber +44 (0)113 4 info@jba-bertle	ET DR DR DR Checker	CT CT CT Approver
CO1.1 P01.4 P01.3 P01.2 PO1.1 Rev. Document Supplier	TOP TRANSI FOR CO MAIN SLOPE PRESSURE F FILL MAT PRELIMINA Description nt Control T Description nt Control T Title DON RE Title Title DON RE	SCAL TION RAMP REVISED ONSTRUCTION GRADIENT AMENDED RELIEF PIPES ADDED TERIAL CHANGE RY DESIGN STAGE Bentl Bentl EGULATOR EGULATOR	E 1:100 11.07.23 07.06.23 09.12.22 25.11.22 20.10.22 Date CS - M CE FIS	AB AB AB AB AB AB AB AUthor It B 2 Lu Li Li Li Li Li Li Li Li Li Li Li Li Li	ET DP AB AB AB AB Designer St Floor, ank House, 7 King Street, eeds, S1 2HL +44 (0)113 4 info@jba-ber +44 (0)113 4 info@jba-bertle	ET DR DR DR Checker	CT CT CT Approver
CO1.1 P01.4 P01.3 P01.2 PO1.1 Rev. Document Supplier	TOP TRANSI FOR CO MAIN SLOPE PRESSURE F FILL MAT PRELIMINA Description nt Control T Tothe DON RE DON RE	SCAL TION RAMP REVISED ONSTRUCTION GRADIENT AMENDED RELIEF PIPES ADDED TERIAL CHANGE RY DESIGN STAGE Bentl Bentl EGULATOR EGULATOR	E 1:100 11.07.23 07.06.23 09.12.22 25.11.22 20.10.22 Date CS - M CS - M CEFIS CONTON	AB AB AB AB AB AB AB AUthor It B 2 Lu Li Li Li Li Li Li Li Li Li Li Li Li Li	ET DP AB AB AB AB Designer St Floor, ank House, 7 King Street, eeds, S1 2HL +44 (0)113 4 info@jba-ber +44 (0)113 4 info@jba-bertle	ET DR DR DR Checker	CT CT CT Approver
CO1.1 P01.4 P01.3 P01.2 PO1.1 Rev. Document Supplier	TOP TRANSI FOR CO MAIN SLOPE PRESSURE F FILL MAT PRELIMINA Description nt Control T Tothe DOON RE Title DON RE MODEL Gassification	SCAL TION RAMP REVISED ONSTRUCTION GRADIENT AMENDED RELIEF PIPES ADDED TERIAL CHANGE RY DESIGN STAGE Bentl Bentl EGULATOR EGULATOR	E 1:100 11.07.23 07.06.23 07.06.23 09.12.22 20.10.22 20.10.22 Date Contection Con	AB AB AB AB AB Author I I E AU C I S H I S I S	ET DP AB AB AB AB Designer St Floor, ank House, 7 King Street, eeds, S1 2HL +44 (0)113 4 info@jba-ber +44 (0)113 4 info@jba-bertle	ET DR DR DR Checker	CT CT CT Approver
CO1.1 P01.4 P01.3 P01.2 PO1.1 Rev. Document Supplier	TOP TRANSI FOR CO MAIN SLOPE PRESSURE F FILL MAT PRELIMINA Description nt Control T Tothe DOON RE Title DON RE MODEL Gassification	SCAL TION RAMP REVISED ONSTRUCTION GRADIENT AMENDED RELIEF PIPES ADDED TERIAL CHANGE RY DESIGN STAGE BENTI EGULATOR EGULATOR EADOWGAS	E 1:100 11.07.23 07.06.23 09.12.22 25.11.22 20.10.22 Date CS - M CS - M CEFIS CONTONNE	AB AB AB AB AB Author I I E AU C I S H I S I S	ET DP AB AB AB AB Designer St Floor, ank House, 7 King Street, eeds, S1 2HL +44 (0)113 4 info@jba-bentle COWO DOWO	ET DR DR Checker	CT CT CT Approver
CO1.1 P01.4 P01.3 P01.2 PO1.1 Rev. Documen Supplier Project	TOP TRANSI FOR CO MAIN SLOPE PRESSURE F FILL MAT PRELIMINA Description nt Control T Tothe DOON RE Title DON RE MODEL Gassification	SCAL TION RAMP REVISED ONSTRUCTION GRADIENT AMENDED RELIEF PIPES ADDED TERIAL CHANGE RY DESIGN STAGE Bentl Bentl GULATOR EGULATOR	E 1:100 11.07.23 07.06.23 09.12.22 25.11.22 20.10.22 Date CYNO CS - M CEFIS CON CON CON CON CON CON CON CON	AB AB AB AB AB AB AUTHOR AUTHOR AUTHOR AUTHOR AD AUTHOR AD AD AB AB AB AB AB AB AB AB AB AB AB AB AB	ET DP AB AB AB AB Designer St Floor, ank House, 7 King Street, eeds, S1 2HL +44 (0)113 4 info@jba-bentle COWO DOWO	ET DR DR Checker	CT CT CT Approver
CO1.1 P01.4 P01.3 P01.2 PO1.1 Rev. Documen Supplier Project	TOP TRANSI FOR CO MAIN SLOPE PRESSURE F FILL MAT PRELIMINA Description nt Control T Description nt Control T T DON RE DON RE T Title DON RE MODEL Classification Classification Classification Classification Classification	SCAL TION RAMP REVISED ONSTRUCTION GRADIENT AMENDED RELIEF PIPES ADDED TERIAL CHANGE RY DESIGN STAGE BENTI BENTI EGULATOR EGULATOR EADOWGAS	E 1:100 11.07.23 07.06.23 09.12.22 25.11.22 20.10.22 Date Checker Checker	AB AB AB AB AB AB AUTHOR AUTHOR AUTHOR AUTHOR AD AUTHOR AD AD AB AB AB AB AB AB AB AB AB AB AB AB AB	ET DP AB AB AB AB Designer St Floor, ank House, 7 King Street, eeds, S1 2HL +44 (0)113 4 info@jba-bentle DOWO DOWO DOWO	ET DR DR DR Checker Checker	CT CT CT Approver
CO1.1 P01.4 P01.3 P01.2 PO1.1 Rev. Documen Supplier Project	TOP TRANSI FOR CA MAIN SLOPE PRESSURE F FILL MAT PRELIMINA Description nt Control T DESCRIPTION T TITLE DON RE DON RE TITLE CON RE TITLE CON RE	SCAL TION RAMP REVISED ONSTRUCTION GRADIENT AMENDED RELIEF PIPES ADDED TERIAL CHANGE RY DESIGN STAGE BENTI BENTI EGULATOR EGULATOR EADOWGAS	E 1:100 11.07.23 07.06.23 09.12.22 25.11.22 20.10.22 Date Checker Checker	AB AB AB AB AB AB AUTHOR AUTHOR AUTHOR AUTHOR AD AUTHOR AD AD AB AB AB AB AB AB AB AB AB AB AB AB AB	ET DP AB AB AB AB AB Designer st Floor, ank House, 7 King Street, eeds, S1 2HL +44 (0)113 4 info@jba-ber +44 (0)113 4 info@jba-ber HA DOWO	ET DR DR DR Checker Checker	CT CT CT Approver

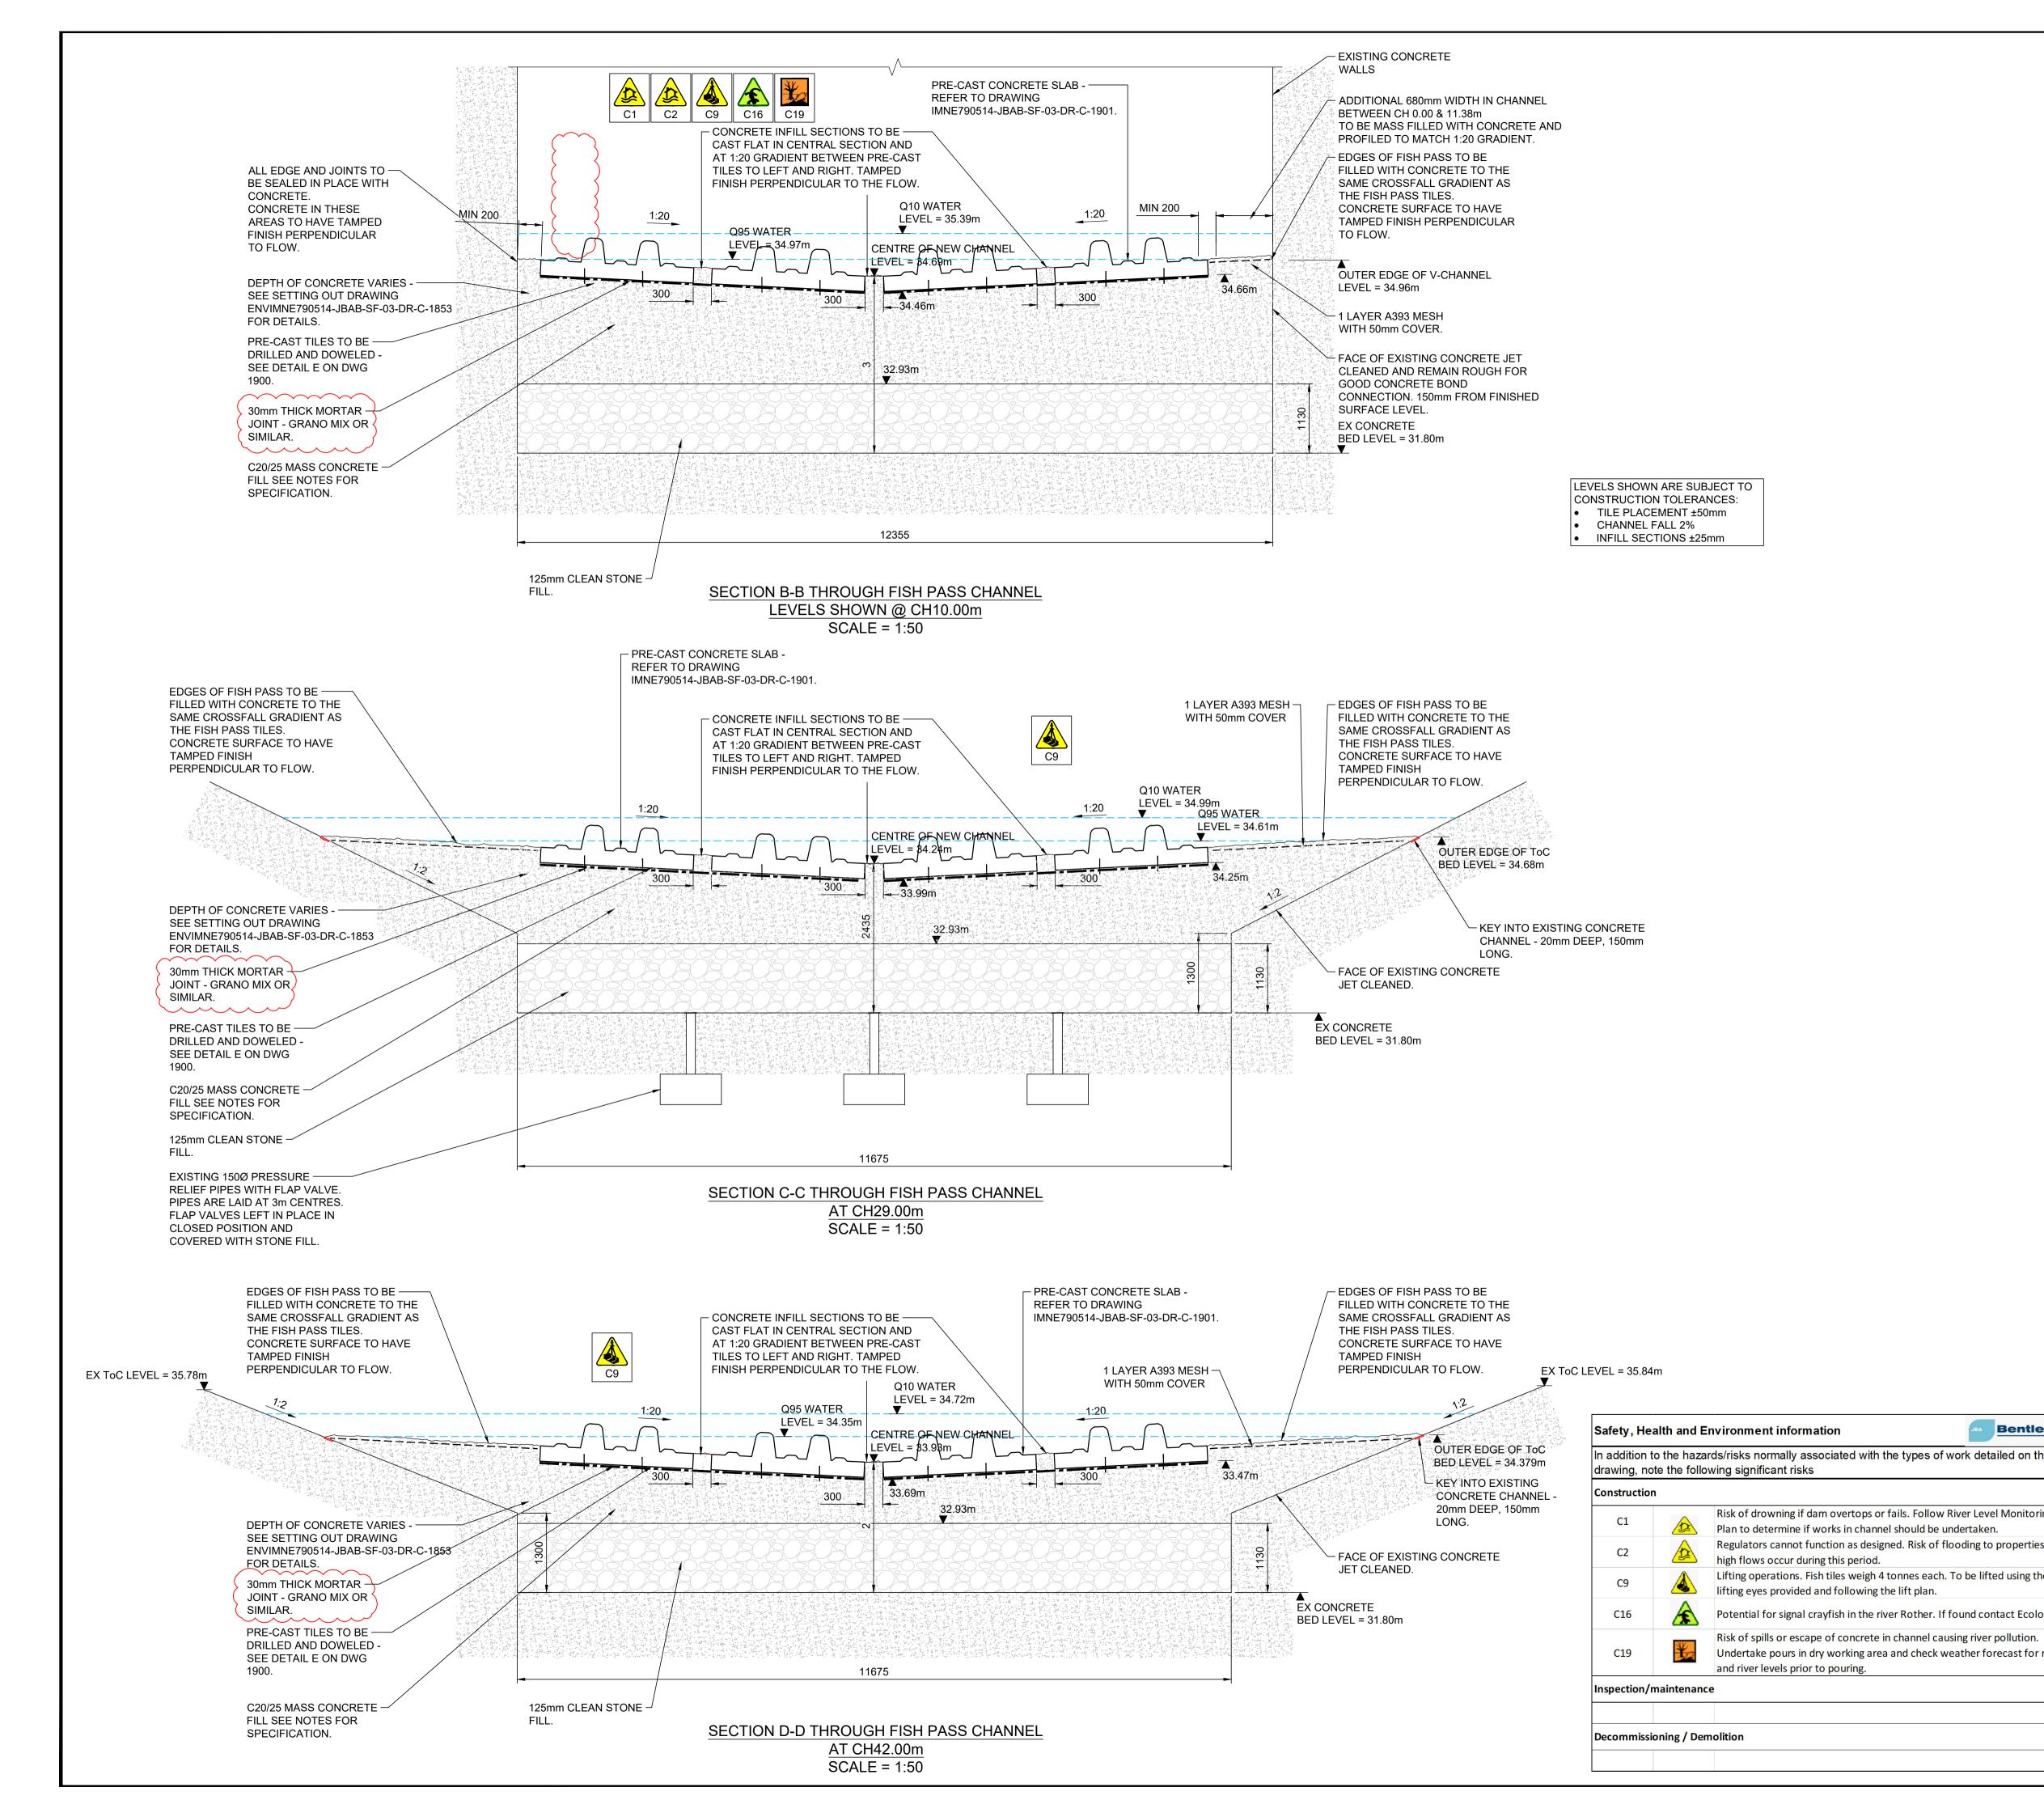

	4. DO NOT SCALE FROM THIS DRAWING. ALL DIMENSIONS MUST BE CHECKE VERIFIED ON SITE. 5. ANY DISCREPANDES NOTED ON SITE ARE TO BE REPORTED TO THE DESIGNER MIMEDIATELY. 6. THE ELECTRONIC VERSION OF THIS DRAWING IS NOT TO BE USED FOR SETTING OUT 7. FOR HAZARDS AND CONSTRAINTS, SERVICE LOCATIONS AND SHEW BOXI REFER TO DRAWING MAYERSOB 14.JBAB-SF-03.DR.2-0028. 8. CONCRETE SPECIFICATION FOR MASS FILL: C2025 LOW CARBON CONCREMIX TO BE AGREED WITH DESIGNER ONCE ENQUIRIES HAVE BEEN RECORD DRAWING TO BE READ IN CONJUNCTION WITH THE FOLLOWING DRAWINGS: INNET80514.JBAB-SF-03.DR.2-180.FISH PASS_CONS TRUCTOND INNET80514.JBAB-SF-03.DR.2-180.FISH PASS_CONS TRUCTOND DETAILS INNET80514.JBAB-SF-03.DR.2-180.FISH PASS_CONS TRUCTOND DETAILS INNET80514.JBAB-SF-03.DR.2-180.FISH PASS_CONS TRUCTOND DETAILS INNET80514.JBAB-SF-03.DR.2-190.FISH PASS_CONSTRUCTOND DETAILS INNET80514.JBAB-SF-03.DR.2-190.FISH PASS_CONSTRUCTOND DETAILS INNET80514.JBAB-SF-03.DR.2-190.FISH PASS_CONSTRUCTOND DETAILS INNET80514.JBAB-SF-03.DR.2-190.FISH PASS_CONSTRUCTOND DETAILS INNET80514.JBAB-SF-03.DR.2-190.FISH PASS_CONSTRUCTON DETAILS INNET80514.JBAB-SF-03.DR.2-190.FISH PASS_CONSTRUCTON DO O CONCRETE E - LIFTING FYE DI - DOWEL HOLE PR = PRESSURE RELIEF HOLE DI - DOWEL MORTA SPEC REVISED 110.7.23 AB ET	4. DO NOT SCALE FROM THIS DRAWING: ALL DIMENSIONS MUST BE CHECKE VERIFIED ON SITE. 5. ANY DISCREPANCIES NOTED ON SITE ARE TO BE REPORTED TO THE DESIGNER MMEDIATELY. 6. THE ELECTRONIC VERSION OF THIS DRAWING IS NOT TO BE USED FOR SETTING OUT. 7. FOR HAZARDS AND CONSTRAINTS, SERVICE LOCATIONS AND SHEW BOXE REFER TO DRAWING MNED MEDIATELY. 8. CONCRETE SPECIFICATION FOR MASS FILL: C2020 LOW CARBON CONCREI MIX TO BE ARGED WIT DESIGNER ONCE ENQUINES FILME SEEN RECOM IMNE730514-BAB-SF-03-DR-C-1700-FISH_PASS_CONSTRUCTION DETAILS IMNE730514-BAB-SF-03-DR-C-1802-FISH_PASS_CONSTRUCTION DETAILS IMNE730514-BAB-SF-03-DR-C-1802-FISH_PASS_CONSTRUCTION DETAILS IMNE730514-BAB-SF-03-DR-C-1802-FISH_PASS_CONSTRUCTION DETAILS IMNE730514-BAB-SF-03-DR-C-1802-FISH_PASS_CONSTRUCTION DETAILS IMNE730514-BAB-SF-03-DR-C-1802-FISH_PASS_CONSTRUCTION_DETAILS IMNE730514-BAB-SF-03-DR-C-1802-FISH_PASS_CONSTRUCTION_DETAILS IMNE730514-BAB-SF-03-DR-C-1802-FISH_PASS_CONSTRUCTION_DETAILS IMNE730514-BAB-SF-03-DR-C-1802-FISH_PASS_CONSTRUCTION_DETAILS IMNE730514-BAB-SF-03-DR-C-1802-FISH_PASS_CONSTRUCTION_DETAILS IMNE730514-BAB-SF-03-DR-C-1802-FISH_PASS_CONSTRUCTION_DETAILS IMNE730514-BAB-SF-03-DR-C-1802-FISH_PASS_CONSTRUCTION_DETAON SITE ARE TO BE REPORTED TO THE DESIGNER IMMEDIATELY. 6. THE ELECTRONIC VERSION OF THIS DRAWING IS NOT TO BE USED FOR SETTING OUT 7. FOR HAZARDS AND CONSTRAINTS, SERVICE LOCATIONS AND SHEW BOXE REFER TO DRAWING MIXPRO514-JBAS-P-03-DR-20028. 8. CONCRETE SPECIFICATION FOR MASS FILL: C2026 LOW CARBON CONCRIMING TO BE READ IN CONJUNCTION WITH THE FOLLOWING DRAWINGS: IMNET90514-JBAB-SF-03-DR-2-1900-FISH-PASS_CONS TRUCTION DETAILS INNET90514-JBAB-SF-03-DR-2-1900-FISH-PASS_CONS TRUCTION_DETAILS INNET90514-JBAB-SF-03-DR-2-1900-FISH-PASS_CONS TRUCTION_DETAILS INNET90514-JBAB-SF-03-DR-2-1900-FISH-PASS_CONS TRUCTION_DETAILS INNET90514-JBAB-SF-03-DR-2-1900-FISH-PASS_CONSTRUCTION_DETAILS INNET90514-JBAB-SF-03-DR-2-1900-FISH-PASS_CONSTRUCTION_DETAILS INNET90514-JBAB-SF-03-DR-2-1900-FISH-PASS_CONSTRUCTION_DETAILS INNET90514-JBAB-SF-03-DR-2-1900-FISH-PASS_CONSTRUCTION_DETAILS INNET90514-JBAB-SF-03-DR-2-1900-FISH-PASS_CONSTRUCTION_DETAILS INNET90514-JBAB-SF-03-DR-2-1900-FISH-PASS_CONSTRUCTION_DETAILS INNET90514-JBAB-SF-03-DR-2-1900-FISH-PASS_CONSTRUCTION_DRAWING BBREVATORS: TOC TOP OF CONCRETE LE LE LIFTING EYE DHOWEL HOLE PR = PRESSURE RELIEF HOLE SCALE 1:50 C22 MORTAR SPEC REVISED 1107.23 AB ET C10 FOR ONSTRUCTION 07.06.23 AB DR C11 FOR ONSTRUCTION 07.06.23 AB AB DR C12 FOR ONSTRUCTION 07.06.23 AB DR	5. AAV DISCREPANCIES NOTED ON SITE ARE TO BE REPORTED TO THE DESIGNER IMMEDIATELY. 6. THE ELECTRONIC VERSION OF THIS DRAWING IS NOT TO BE USED FOR SETTING OUT 7. FOR HAZARDS AND CONSTRAINTS, SERVICE LOCATIONS AND SHEW BOXI REFER TO DRAWING IMMET90514-JBAB-57-03-DR-2-0025.LOW CARBON CONCRIMIX TO BE AGREED WITH DESIGNER ONCE ENQURIES HAVE BEEN RECET DRAWING TO BE READ IN CONJUNCTION WITH THE FOLLOWING DRAWINGS: INNET700514-JBAB-57-03-DR-2-1700-FISH PASS_CONSTRUCTION DETAILS INNET700514-JBAB-57-03-DR-2-1900-FISH PASS_CONSTRUCTION DETAILS INNET700514-JBAB-57-03-DR-C-1900-FISH PASS_CONSTRUCTION DETAILS INNET700514-JBAB-57-03-DR-C-1901-FISH PASS_CONSTRUCTION DE	5. ANY DISCREPANCIES NOTED ON SITE ARE TO BE REPORTED TO THE DESIGNER MMEDIATELY. 6. THE ELECTRONIC VERSION OF THIS DRAWING IS NOT TO BE USED FOR SETTING OUT 7. FOR HAZARDS AND CONSTRAINTS, SERVICE LOCATIONS AND SHEW BOXE REFER TO DE RAVED MUTH DESIGNER ONCE ENOURIES HAVE BEEN RECORD DRAWING INS FRIENDS SHAVE BEEN RECORD DRAWING MESTING TO BE REFER TO DE READ IN CONJUNCTION WITH THE FOLLOWING DRAWINGS: INNE770514-IBAB-SF-03-DR-C-1700-FISH PASS_CONSTRUCTION DETAILS INNE770514-IBAB-SF-03-DR-C-1800-FISH PASH INTO TO EDIALS INTERVISION DETAILS INTO TO TO 223 AB DP ETAILS INTERVISION DETAILS INTO TO PASH INTO TO TO 223 AB DP ETAILS INTO TO PASH INTO TO TO 223 AB DP ETAILS INTO TO PARABINES INTO	١	IATIONAL GRID. OO NOT SCALE FROM THIS DRAWING					(EC
SETTING OUT . FOR HAZROS AND CONSTRAINTS, SERVICE LOCATIONS AND SHEW BOXE REFER TO DRAWING IMNE790514-JBAB-SF-03-DR-20038. CONCRETE SPECIFICATION FOR MASS FILL: C20/2S LOW CARBON CONCRI MIX TO BE AGREED WITH DESIGNER ONCE ENOUTRIES HAVE BEEN RECEN DRAWING TO BE READ IN CONJUNCTION WITH THE FOLLOWING DRAWINGS: IMNE790514-JBAB-SF-03-DR-C-1700-FISH_PASS_CENERL_ARRANGEMENT_PLAI IMNE790514-JBAB-SF-03-DR-C-1800-FISH_PASS_CONSTRUCTION_DETAILS IMNE790514-JBAB-SF-03-DR-C-1800-FISH_PASS_CONSTRUCTION_DETAILS IMNE790514-JBAB-SF-03-DR-C-1800-FISH_PASS_CONSTRUCTION_DETAILS IMNE790514-JBAB-SF-03-DR-C-1901-FISH_PASS_CONSTRUCTION_DRAWING ABBREVIATIONS: T0C = TOP OF CONCRETE LE LIETING DE YE DH = DOWEL HOLE PR = PRESSURE RELIEF HOLE Q1 Q2_00_02_00_03_CV_1_ACAZROS_PLAN SCALE 1:50 Q2 MORTAR SPEC REVISED 11.07.23 A8 ET ET Q3 CONCRETE PROFILE ALSO 03.08.22 A8 DR ET Q1 MORTAR SPEC REVISED 11.07.23 A8 ET ET Q3 CONCRETE PROFILE ALSO 03.03.23 A8 DR Q2 MORTAR SPEC REVISED 11.07.23 A8 ET ET Q3 CONCRETE PROFILE ALSONEE FILL 03.03.23 A8 DR DR Q2 FILL MATERIAL CHANGE 25.11.22 A8 DR DR 27.11.29.11.20.	SETTING OUT . FOR HAZARDS AND CONSTRAINTS, SERVICE LOCATIONS AND SHEW BOXI REFER TO DRAWING IMME790514-JBAB-SF-03-DR-Z-0038. . CONCRETE SPECIFICATION FOR MASS FILL: C2025 LOW CARBON CONCRE MIX TO BE AGREED WITH DESIGNER ONCE ENQUIRIES HAVE BEEN RECEPT DRAWING TO BE READ IN CONJUNCTION WITH THE FOLLOWING DRAWINGS: . IMME700514-JBAB-SF-03-DR-C-1700-FISH PASS_CENTONS_UTOTION_DETAILS IMME700514-JBAB-SF-03-DR-C-1800-FISH PASS_CONSTRUCTION_DETAILS IMME700514-JBAB-SF-03-DR-C-1800-FISH PASS_CONSTRUCTION_DETAILS IMME700514-JBAB-SF-03-DR-C-1801-FISH PASS_CONSTRUCTION_DETAILS IMME700514-JBAB-SF-03-DR-C-1801-FISH PASS_CONSTRUCTION_DETAILS IMME700514-JBAB-SF-03-DR-C-1801-FISH PASS_CONSTRUCTION_DRAWING ABBREVIATIONS: TC = TOP OF CONCRETE LE - LIFTING EYE DH = DOWEL HOLE . SCALE 1:50 C021 MORTAR SPEC REVISED 1107.23 AB ET ET C031 FOR CONSTRUCTION 07.06.23 AB DP ET C031 FOR CONSTRUCTION 07.06.23 AB DR DR C031 FOR CONSTRUCTION 07.06.23 AB DR DR C031 FOR CONSTRUCTION 07.06.23 AB AB DR C032 FULL MATERIAL CHANGE 25.13.22 AB AB DR C032 FULL MATERIAL CHANGE 25.13.22 AB AB DR C033	SETTING OUT . FOR HAZNES AND CONSTRAINTS, SERVICE LOCATIONS AND SHEW BOXE REFER TO DRAWING IMNE790514.JBAB-SF-03.DR.Z.0038. CONCRETE SPECIFICATION FOR MASS FILL: 202/SE LOW CARBON CONCRE MIX TO BE AGREED WITH DESIGNER ONCE ENQUIRIES HAVE BEEN RECENT DRAWING TO BE READ IN CONJUNCTION WITH THE FOLLOWING DRAWINGS: IMNE790514.JBAB-SF-03.DR.C-1700-FISH_PASS_CENERL_ARRANGEMENT_PLAI IMNE790514.JBAB-SF-03.DR.C-1800-FISH_PASS_CONSTRUCTION_DETAILS IMNE790514.JBAB-SF-03.DR.C-1800-FISH_PASS_CONSTRUCTION_DETAILS IMNE790514.JBAB-SF-03.DR.C-1800-FISH_PASS_CONSTRUCTION_DETAILS IMNE790514.JBAB-SF-03.DR.C-1800-FISH_PASS_CONSTRUCTION_DRAWING ABBEEVATIONS: T0C TOP COCOCRETE LE = LIFTING EYE DH = DOWEL FOLCE DF = DOWEL FOLCE RE79514.JBAB-SF-03.DR.C-1800-FISH_PASS_TILE_FABRICATION_DRAWING ABBEEVATIONS: T0C TOP COCOCRETE LE = LIFTING EYE DH = DOWEL FOLCE RE70514.JBAB-SF-03.DR.C-1800-FISH_PASS_TILE_FABRICATION_DRAWING ABBEEVATIONS: T0C TOP COCOCRETE LE = LIFTING EYE DH = DOWEL FOLCE RE = PRESSURE RELIEF HOLE	5. A D	NY DISCREPANCIES NOTED ON SITE DESIGNER IMMEDIATELY.					
8. EFER TO DRAWING IMNE790514-JBAB-SF-03-DR-2-0038. 8. CONCRETE SPECIFIC/INFO FOR MASS FILL: C20/25 LOW CARBON CONCRET IMNE TO BE AGREED WITH DESIGNER ONCE ENQUIRIES HAVE BEEN RECENT IMNE700514-JBAB-SF-03-DR-C-1700-FISH PASS_CENERL_ARRANGEMENT_PLAI IMNE700514-JBAB-SF-03-DR-C-1800-FISH PASS_CONSTRUCTION_DETALS IMNE700514-JBAB-SF-03-DR-C-1800-FISH PASS_CONSTRUCTION_DETALS IMNE700514-JBAB-SF-03-DR-C-1800-FISH PASS_CONSTRUCTION_DETALS IMNE700514-JBAB-SF-03-DR-C-1800-FISH PASS_CONSTRUCTION_DETALS IMNE700514-JBAB-SF-03-DR-C-1800-FISH PASS_CONSTRUCTION_DETALS IMNE700514-JBAB-SF-03-DR-C-1800-FISH PASS_CONSTRUCTION_DETALS IMNE700514-JBAB-SF-03-DR-C-1800-FISH PASS_CONSTRUCTION_DETALS IMNE700514-JBAB-SF-03-DR-C-1800-FISH PASS_CONSTRUCTION_DRAWING IMNE700514-JBAB-SF-03-DR-C-1800-FISH PASS_CONSTRUCTION_DRAWING IMNE700514-JBAB-SF-03-DR-C-1800-FISH PASS_CONSTRUCTION_DRAWING LE2 LIFTING FYE L= LIFTING FYE DEVEL HOLE Imne700514-JBAB-SF-03-DR-C-1800-FISH PASS_CONSTRUCTION_DRAWING LE3 LIFTING FYE DAST L L Imne700514-JBAB-SF-03-DR-C-1800-FISH PASS_CONSTRUCTION_DRAWING LE3 LIFTING FYE DAST L L L L LE3 LIFTING FYE DAST L L L L LIFTING FYE DAST L L L	8. REFER TO DRAWING IMME790514-JBAB-SF-03-DR2-0038. 8. CONCRETE SPECIFIC/LING FOR MASS FILL: C20/25 LOW CARBON CONCRE IMME TO BE AGREED WITH DESIGNER ONCE ENQUIRIES HAVE BEEN RECEPT DRAWING TO BE READ IN CONJUNCTION WITH THE FOLLOWING DRAWINGS: IMME700514-JBAB-SF-03-DR-C-1700-FISH PASS_CONSTRUCTION_DETAILS IMME700514-JBAB-SF-03-DR-C-1800-FISH PASS_CONSTRUCTION_DETAILS IMME700514-JBAB-SF-03-DR-C-1800-FISH PASS_CONSTRUCTION_DETAILS IMME700514-JBAB-SF-03-DR-C-1800-FISH PASS_CONSTRUCTION_DETAILS IMME700514-JBAB-SF-03-DR-C-1800-FISH PASS_CONSTRUCTION_DETAILS IMME700514-JBAB-SF-03-DR-C-1800-FISH PASS_CONSTRUCTION_DETAILS IMME700514-JBAB-SF-03-DR-C-1800-FISH PASS_CONSTRUCTION_DRAWING ABBREVIATIONS TC = TOP OF CONCRETE LE LE - LIFTING EYE DH = DOWEL HOLE DIF = DOWEL HOLE SCALE 1:50 C021 MORTAR SPEC REVISED 11.07.23 AB ET C01 FOR CONSTRUCTION 07.06.23 AB DR C011 REPLIE & CONCRETE FILL 30.03.22 AB AB DR LEVELID Excitution Date Abit Descrete Date Abit Descrete Date C01 FOR CONSTRUCTION TO.2 AB AB	REFER TO DRAWING IMME79051-JBAB-SF-03-DR-20038. 8. CONCRETE SPECIFICATION FOR MASS FILL: C20/SLOW CARBON CONCREMIX TO BE AGREED WITH DESIGNER ONCE ENQUIRIES HAVE BEEN RECENT DRAWING TO BE READ IN CONJUNCTION WITH THE FOLLOWING DRAWINGS: IMME790514-JBAB-SF-03-DR-C-1800-FISH_PASS_CONSTRUCTION_DETAILS IMME790514-JBAB-SF-03-DR-C-1800-FISH_PASS_CONSTRUCTION_DETAILS IMME790514-JBAB-SF-03-DR-C-1800-FISH_PASS_CONSTRUCTION_DETAILS IMME790514-JBAB-SF-03-DR-C-1800-FISH_PASS_CONSTRUCTION_DETAILS IMME790514-JBAB-SF-03-DR-C-1800-FISH_PASS_CONSTRUCTION_DRAWING IMME790514-JBAB-SF-03-DR-C-1800-FISH_PASS_CONSTRUCTION_DRAWING IMME790514-JBAB-SF-03-DR-C-1800-FISH_PASS_CONSTRUCTION_DRAWING IMME790514-JBAB-SF-03-DR-C-1801-FISH_PASS_TILE_FABRICATION_DRAWING IMME790514-JBAB-SF-03-DR-C-1801-FISH_PASS_TILE_FABRICATION_DRAWING IMME790514-JBAB-SF-03-DR-C-1801-FISH_PASS_TILE_FABRICATION_DRAWING IMME790514-JBAB-SF-03-DR-C-1801-FISH_PASS_TILE_FABRICATION_DRAWING IMME790514-JBAB-SF-03-DR-C-1801-FISH_PASS_TILE_FABRICATION_DRAWING IMME790514-JBAB-SF-03-DR-C-1801-FISH_PASS_TILE_FABRICATION_DRAWING IMME790514-JBAB-SF-03-DR-C-1801-FISH_PASS_DRAWING IMME790514-JBAB-SF-03-DR-C-1801-FISH_PASS_TILE_FABRICATION_DRAWING IME70514-JBAB-SF-03-DR-C-1801-FISH_PASS_DRAWING IMME790514-JBAB-SF-03-DR-C-1803-FISH_PASS_DRAWING IME70514-JBAB-SF-03-DR-C-1801-FISH_PASS_DRAWING IMME790514-JBAB-SF-03-DR-C-1803-FISH_PASS_DRAWING	6. T S	HE ELECTRONIC VERSION OF THIS I	_				~=
INNE790514-JBAB-SF-03-DR-C-1700-FISH_PASS_CENER_ARRANGEMENT_PLAI INNE790514-JBAB-SF-03-DR-C-1800-FISH PASS_CONSTRUCTION_DETAILS INNE790514-JBAB-SF-03-DR-C-1900-FISH PASS_SOPS INNE790514-JBAB-SF-03-DR-C-1901-FISH_PASS_SOPS INNE790514-JBAB-SF-03-DR-C-1901-FISH_PASS_STILE_FABRICATION_DRAWING ABBREVATIONS: TOC 1 TOP OF CONCRETE LE - LIFTING EXE DE = LIFTING EXE DE = DOWEL HOLE PR = PRESSURE RELIEF HOLE Internet in the second state of the sec	IMNE790514-JBAB-SF-03-DR-C-1700-FISH_PASS_CONSTRUCTION_DETAILS IMNE790514-JBAB-SF-03-DR-C-1900-FISH_PASS_CONSTRUCTION_DETAILS IMNE790514-JBAB-SF-03-DR-C-1900-FISH_PASS_CONSTRUCTION_DETAILS IMNE790514-JBAB-SF-03-DR-C-1900-FISH_PASS_SOPS IMNE790514-JBAB-SF-03-DR-C-1901-FISH_PASS_SOPS IMNE790514-JBAB-SF-03-DR-C-1901-FISH_PASS_STLE_FABRICATION_DRAWING BBBEVIATIONS: TCC = TOP OF CONCRETE LE = LIFTING EYE D1 = DOWEL HOLE PR = PRESSURE RELIEF HOLE SCALE 1:50 Color FOR CONSTRUCTION 076 2 ON ORTAR SPEC REVISED 110723 AB ET ET Color FOR CONSTRUCTION 076623 AB DP ET 031 CONCRETE PROFILE SCONCRETE FLUENCE 110723 AB AB DR	IMNE790514-JBAB-SF-03-DR-C-1780-FISH_PASS_CONSTUCTION_DETAILS IMNE790514-JBAB-SF-03-DR-C-1800-FISH_PASS_CONSTUCTION_DETAILS IMNE790514-JBAB-SF-03-DR-C-1800-FISH_PASS_CONSTUCTION_DETAILS IMNE790514-JBAB-SF-03-DR-C-1800-FISH_PASS_CONSTUCTION_DETAILS IMNE790514-JBAB-SF-03-DR-C-1805-FISH_PASS_SOPS IMNE790514-JBAB-SF-03-DR-C-1805-FISH_PASS_CONSTUCTION_DRAWING ABBREVIATIONS: TOC = TOP OF CONCRETE LE - LIFTING FYE LE - LIFTING FYE DH = DOWEL HOLE PR = PRESSURE RELIEF HOLE Cold Cold MORTAR SPEC REVISED 11.0723 AB ET ET Cold FOR CONSTRUCTION 07.0623 AB DP ET Poil FORLMAR SPEC REVISED 11.0723 AB AB DR Poil CONCRETE HOPEL 20.022 AB AB DR COCCIN FOR CONSTRUCTION 07.023 AB AB DR CONCRETE PROPELS 20.1022 AB AB DR 21.022 AB AB DR Poil FELLIMARED TO REFLICE TEXSTING 00.03.23	8. C	EFER TO DRAWING IMNE790514-JBA	B-SF-03-E S FILL: C2	0R-Z-003 20/25 LC	38. W CARBC	N CONC	RE
IMNE790514-JBAB-SF-03-DR-C-1860-FISH PASS_CONS_TRUCTION_DETAILS IMNE790514-JBAB-SF-03-DR-C-1900-FISH PASS_CONSERUCTION_DETAILS IMNE790514-JBAB-SF-03-DR-C-1900-FISH PASS_SOPS IMNE790514-JBAB-SF-03-DR-C-1901-FISH PASS_SOPS IF STATUS IMNE70517 IF STATUS IMNE70517 IMNE70517 IMNE70517 IMNE70517 IMNE70517 IMNE70517 IMNE70517 IMNE70517 IMNE70517	IMNE700514-JBAB-SF-03-DR-C-1860-FISH PASS_CONSTRUCTION_DETALLS IMNE700514-JBAB-SF-03-DR-C-1800-FISH PASS_CONSTRUCTION_DETALLS IMNE700514-JBAB-SF-03-DR-C-1800-FISH PASS_COCESS_PLAN IMNE700514-JBAB-SF-03-DR-C-1800-FISH PASS_SOPS IMNE700514-JBAB-SF-03-DR-C-1901-FISH PASS_SOPS IMNE700514-JBAB-SF-03-DR-C-1901-FISH PASS_STILE_FABRICATION_DRAWING ABBREVATIONS: TOC = TOP OF CONCRETE LE = LIFTING EYE DH = DOWEL HOLE PR = PRESSURE RELIEF HOLE SCALE 1:50 C2:1 MORTAR SPEC REVISED 1107.23 AB ET ET C0:1 FOR CONSTRUCTION 07.6623 AB DP ET C0:1 FOR CONSTRUCTION 07.6623 AB AB DR P0:1 PRELIMINARY DESIGN STAGE 20.10.22	IMNE720514-JBAB-SF-03-DR-C-1850-FISH PASS_CONSTRUCTION_DETAILS IMNE720514-JBAB-SF-03-DR-C-1800-FISH PASS_CONSTRUCTION_DETAILS IMNE720514-JBAB-SF-03-DR-C-1800-FISH PASS_SOPS IMNE720514-JBAB-SF-03-DR-C-1805-FISH PASS_SOPS IMNE70517-DPT OF CONCRETE LE LIFTING FYE DH = DOWEL HOLE PR = PRESSURE RELIEF HOLE Color SCALE 1:50 Color FOR CONSTRUCTOR Color FOR CONSTRUCTOR LEVELTING SCALE 1:50 Color FOR CONSTRUCTOR Color FOR CONSTRUCTOR P01.1 CONCRETE FILL 30.33.23 AB AB DR P01.1 FIELININARY DESIGN STAGE 20.30.22 AB AB DR P01.1 FIELININARY DESIGN STAGE 20.30.22 AB AB DR P01.1 FIELININARY DESIGN STAGE 20.30.22 </th <th>DRAV</th> <th>VING TO BE READ IN CONJUNCTION \</th> <th>WITH THE</th> <th>FOLLO</th> <th>WING DRA</th> <th>WINGS:</th> <th></th>	DRAV	VING TO BE READ IN CONJUNCTION \	WITH THE	FOLLO	WING DRA	WINGS:	
IMNE72001-J.BAB-SF-03-DR-C-1600-FISH PASS_ACCESS_PLAN IMNE72001-J.BAB-SF-03-DR-C-1001-FISH_PASS_SOPS IMNE72001-J.BAB-SF-03-DR-C-1901-FISH_PASS_SOPS IMNE7001-J.BAB-SF-03-DR-C-1901-FISH_PASS_SOPS	IMNE720014-JBAB-SF-03-DR-C-1600-FISH PASS_ACCESS_PLAN IMNE720014-JBAB-SF-03-DR-C-1001-FISH_PASS_SOPS IMNE70014-JBAB-SF-03-DR-C-1901-FISH_PASS_SOPS IMNE70014-JBAB-SF-03-DR-C-1901-FISH_PASS_SOPS IMNE70014-JBAB-SF-03-DR-C-1901-FISH_PASS_SOPS IMNE70014-JBAB-SF-03-DR-C-1901-FISH_PASS_SOPS TOC = TOP OF CONCRETE LE = LIFTING EYE D1 = DOWEL HOLE PR = PRESSURE RELIEF HOLE SCALE 1:50 C021 MORTAR SPEC REVISED 11.07.23 AB ET ET C01 FOR CONSTRUCTING 70.62.2 AB DP ET P01.1 PRELIMINARY DESIGN STAGE 23.11.2 AB AB DR P01.1 PRELIMINARY DESIGN STAGE 23.12.2 AB AB	IMNET20011-JBAB-SF-03-DR-C-1600-FISH PASS_ACCESS_PLAN IMNET20011-JBAB-SF-03-DR-C-1003-FISH PASS_SOPS IMNET20011-JBAB-SF-03-DR-C-1803-FISH PASS_SOPS IMNET20011-JBAB-SF-03-DR-C-1803-FISH PASS_SOPS IMNET20011-STERES 11.07.2 AB ET ET IO1 FOR CONSTRUCTION 07.06.23 AB DR DR IO1.1 PRELIMINARY DESIGN STAGE 20.10.22 AB AB DR IO1.1 PRELIMINARY DESIGN STAGE 20.10.22 AB AB DR Date Pace Date Pace Date Pace Date Pace Date Pace Date Pace Date Pace <th>IMNE7</th> <th>790514-JBAB-SF-03-DR-C-1850-FISH_F</th> <th>PASS_LOI</th> <th>NG_SEC</th> <th>TIONS</th> <th>_</th> <th>A.</th>	IMNE7	790514-JBAB-SF-03-DR-C-1850-FISH_F	PASS_LOI	NG_SEC	TIONS	_	A.
IMNE790514-JBAB-SF-4_03-DR-C-1853-FISH_PASS_SOPS IMNE790514-JBAB-SF-03-DR-C-1901-FISH_PASS_TILE_FABRICATION_DRAWING ABBREVIATIONS: ToC TOP OF CONCRETE LE = LIFTING EYE DI = DOWEL HOLE PR = PRESSURE RELIEF HOLE SCALE 1:50 Color For Concerter HOLE To TOP OF CONCETE LE = LIFTING EYE DI = DOWEL HOLE PR = PRESSURE RELIEF HOLE SCALE 1:50 Color For Construction Color For Construction VIEL FROPILE & CONCRETE FILL 30:03:02 AB AB DP EVELS 30:03:22 AB AB P01:1 PRELIMINARY DESIGN STAGE Document Control Date Supplier JBA	IMNE790014-JBAB-SF-4_03-DR-C-1803-FISH_PASS_SOPS IMNE790014-JBAB-SF-03-DR-C-1901-FISH_PASS_TILE_FABRICATION_DRAWING ABBREVATIONS: TOC = TOP OF CONCRETE LE = LIFTING EYE DH = DOWEL HOLE PR = PRESSURE RELIEF HOLE PR = PRESSURE RELIEF HOLE Color SCALE 1:50 Color For construction Concenter Erpoint & construction 70:623 Poil Filteria Poil Filteria Poil Filteria Poil Patientia Poil Patientia Poil Patientia Poil Patientia Poil Patientia Poil Patientia Poila Patientia	IMNE 290014-JBAB-SF-4_03-DR-C-1803-FISH_PASS_SOPS IMNE 290014-JBAB-SF-03-DR-C-1803-FISH_PASS_TILE_FABRICATION_DRAWING ABBREVIATIONS: TOC = TOP OF CONCRETE LE - LIFTING EVE DH = DOWEL HOLE PR = PRESSURE RELIEF HOLE PR = PRESSURE RELIEF HOLE SCALE 1:50 Col MORTAR SPEC REVISED 11/07.23 AB ET ET Col FOR CONSTRUCTION 07.06.23 AB DP ET P012 FILL MATERIAL CHANCE 25.11.22 AB AB DR P013 CONCRETE FILL 30.03.23 AB AB DR P014 PILLIMATERIAL CHANCE 25.11.22 AB AB DR P011 PRELIMINARY DESIGN STAGE 20.10.22 AB AB DR P011 PRELIMINARY DESIGN STAGE 20.10.22 AB AB DR P014 PRELIMINARY DESIGN STAGE 20.10.22 AB AB DR P013 PRELIMINARY DESIGN STAGE 20.10.22 AB <th>IMNE7</th> <th>790514-JBAB-SF-03-DR-C-1600-FISH_F</th> <th>PASS_AC</th> <th>CESS_F</th> <th></th> <th>TAILS</th> <th></th>	IMNE7	790514-JBAB-SF-03-DR-C-1600-FISH_F	PASS_AC	CESS_F		TAILS	
ToC = TOP OF CONCRETE E = LIFTING EYE DH = DOWEL HOLE PR = PRESSURE RELIEF HOLE PR = PRESSURE RELIEF HOLE Image: Second Example of Concentration of Concentratio Concent contration of Concentration of Concenteratio	ToC = TOP OF CONCRETE LE = LIFTING EYE DH = DOWEL HOLE PR = PRESSURE RELIEF HOLE PR = PRESSURE RELIEF HOLE SCALE 1:50 C02 MORTAR SPEC REVISED 11:07.23 AB ET ET C01 FOR CONSTRUCTION 021 MORTAR SPEC REVISED 11:07.23 AB ET ET C01 FOR CONSTRUCTION 021 FILL MATERIAL CHANGE 25:11.22 AB P01.1 FILL MATERIAL CHANGE 21:12 AB P01.1 FILL MATERIAL CHANGE SUBJIER Date SUBJIER Date SUBJIER Date SUBJIER ET SUBJIER SUBJIER SUBJIER Date SUBJIER Date SUBJIER ET SUBJIER ET SUBJIER SUBJIER SUBJIER Date SUBJIER Date SUBJIER Date SUBJI	ToC = TOP OF CONCRETE LE - LIFTING FYE DH = DOWEL HOLE PRESSURE RELIEF HOLE PR = PRESSURE RELIEF HOLE SCALE 1:50 SCALE 1:50 SCALE 1:50 COL MORTAR SPEC REVISED 11:07:23 AB ET ET COL FOR CONSTRUCTION 07:06:23 AB DP ET COL FOR CONSTRUCTION 07:06:23 AB DP ET P01.3 CONCRETE FROIL IS CONCRETE FILL 30:03:23 AB AB DR P01.1 FILL MATERIAL CHANGE 25:11:22 AB AB DR P01.1 PRELIMINARY DESIGN STAGE 20:10:22 AB AB DR P01.1 PRELIMINARY DESIGN STAGE 20:10:22 AB AB DR Document Control Stafferstreet Document Control Stafferstreet Document Control	IMNE7	790514-JBAB-SF-4_03-DR-C-1853-FISH	I_PASS_S	OPs	ICATION_	DRAWIN	G
PR = PRESSURE RELIEF HOLE 1 2 15 1 0 3m 1 1 2 3m 3m 3m 1 1 0 1 2 3m 1 1 0 1 0 3m 1 0 1 0 2 3m 1 0 1 0 2 3m 1 0 1 0 2 3m 1 0 0 1 0 3m 1 0 0 0 0 0 0 1 0 <th>PR = PRESSURE RELIEF HOLE 1 2 1 0 3 1 0 1 0 3 3 1 1 0 1 2 3 3 1 0 1 0 2 3 1</th> <th>PR = PRESSURE RELIEF HOLE 2.5m 2.5 1.0.5 0 2 3m SCALE 1:50 C02.1 MORTAR SPEC REVISED 11.07.23 AB ET ET C02.1 MORTAR SPEC REVISED 11.07.23 AB ET ET C02.1 MORTAR SPEC REVISED 11.07.23 AB ET ET C01 FOR CONSTRUCTION 07.06.23 AB DP ET P01.3 CONCRETE PROILLE CO TEXISTING 03.03.23 AB AB DR P01.2 FILL MATERIAL CHANGE 25.11.22 AB AB DR PO P01.1 PRELIMINARY DESIGN STAGE 20.10.22 AB AB OR PO Rev Description Date Author Description ZMG Street, Les 22 MG Street, Les 24 MG Street, Les 32 MG Street, Les 34 MG St</th> <th>ToC = LE = L</th> <th>TOP OF CONCRETE</th> <th></th> <th></th> <th></th> <th></th> <th></th>	PR = PRESSURE RELIEF HOLE 1 2 1 0 3 1 0 1 0 3 3 1 1 0 1 2 3 3 1 0 1 0 2 3 1	PR = PRESSURE RELIEF HOLE 2.5m 2.5 1.0.5 0 2 3m SCALE 1:50 C02.1 MORTAR SPEC REVISED 11.07.23 AB ET ET C02.1 MORTAR SPEC REVISED 11.07.23 AB ET ET C02.1 MORTAR SPEC REVISED 11.07.23 AB ET ET C01 FOR CONSTRUCTION 07.06.23 AB DP ET P01.3 CONCRETE PROILLE CO TEXISTING 03.03.23 AB AB DR P01.2 FILL MATERIAL CHANGE 25.11.22 AB AB DR PO P01.1 PRELIMINARY DESIGN STAGE 20.10.22 AB AB OR PO Rev Description Date Author Description ZMG Street, Les 22 MG Street, Les 24 MG Street, Les 32 MG Street, Les 34 MG St	ToC = LE = L	TOP OF CONCRETE					
SCALE 1:50 C02.1 MORTAR SPEC REVISED 11.07.23 AB ET ET ET C01 FOR CONSTRUCTION 07.06.23 AB DP ET Image: Construction of the second	SCALE 1:50 C02.1 MORTAR SPEC REVISED 11.07.23 AB ET ET C01 FOR CONSTRUCTION 07.06.23 AB DP ET P01.3 AMENDED TO REFLECT EXISTING CONCRETE PROFILE & CONCRETE FILL LEVELS 30.03.23 AB AB DR DR P01.2 FILL MATERIAL CHANGE 25.11.22 AB AB DR DR P01.1 PRELIMINARY DESIGN STAGE 20.10.22 AB AB O I Rev. Description Date Author Designer Checker I Document Control JBA BECITIE N Street, Leeds, Leeds, LST 2HL Street, Leeds, Leeds, LST 2HL LST 2HL T +44 (0)113 426 8536 E info@jba-bentley.co.uk NWW.jba-bentley.co.uk	SCALE 1:50 C02.1 MORTAR SPEC REVISED 11.07.23 AB ET ET C01 FOR CONSTRUCTION 07.06.23 AB DP ET P01.3 AMENDED TO REFLECT EXISTING CONCRETE PROFILE & CONCRETE FILL LEVELS 30.03.23 AB AB DR Image: Concrete Fill Levels 25.11.22 AB AB DR Image: Concrete Fill Levels Image: Concrete Fill Levels 20.10.22 AB AB DR Image: Concrete Fill Levels Image: Concrete Fill Levels </td <td></td> <td></td> <td></td> <td></td> <td></td> <td></td> <td></td>							
SCALE 1:50 C02.1 MORTAR SPEC REVISED 11.07.23 AB ET ET ET C01 FOR CONSTRUCTION 07.06.23 AB DP ET Image: Construction of the second	SCALE 1:50 C02.1 MORTAR SPEC REVISED 11.07.23 AB ET ET C01 FOR CONSTRUCTION 07.06.23 AB DP ET P01.3 AMENDED TO REFLECT EXISTING CONCRETE PROFILE & CONCRETE FILL LEVELS 30.03.23 AB AB DR DR P01.2 FILL MATERIAL CHANGE 25.11.22 AB AB DR DR P01.1 PRELIMINARY DESIGN STAGE 20.10.22 AB AB O I Rev. Description Date Author Designer Checker I Document Control JBA BECITIE N Street, Leeds, Leeds, LST 2HL Street, Leeds, Leeds, LST 2HL LST 2HL T +44 (0)113 426 8536 E info@jba-bentley.co.uk NWW.jba-bentley.co.uk	SCALE 1:50 C02.1 MORTAR SPEC REVISED 11.07.23 AB ET ET C01 FOR CONSTRUCTION 07.06.23 AB DP ET P01.3 AMENDED TO REFLECT EXISTING CONCRETE PROFILE & CONCRETE FILL LEVELS 30.03.23 AB AB DR Image: Concrete Fill Levels 25.11.22 AB AB DR Image: Concrete Fill Levels Image: Concrete Fill Levels 20.10.22 AB AB DR Image: Concrete Fill Levels Image: Concrete Fill Levels </th <th></th> <th></th> <th></th> <th></th> <th></th> <th></th> <th></th>							
SCALE 1:50 C02.1 MORTAR SPEC REVISED 11.07.23 AB ET ET ET C01 FOR CONSTRUCTION 07.06.23 AB DP ET Image: Construction of the second	SCALE 1:50 C02.1 MORTAR SPEC REVISED 11.07.23 AB ET ET C01 FOR CONSTRUCTION 07.06.23 AB DP ET P01.3 AMENDED TO REFLECT EXISTING CONCRETE PROFILE & CONCRETE FILL LEVELS 30.03.23 AB AB DR DR P01.2 FILL MATERIAL CHANGE 25.11.22 AB AB DR DR P01.1 PRELIMINARY DESIGN STAGE 20.10.22 AB AB O I Rev. Description Date Author Designer Checker I Document Control JBA BECITIE N Street, Leeds, Leeds, LST 2HL Street, Leeds, Leeds, LST 2HL LST 2HL T +44 (0)113 426 8536 E info@jba-bentley.co.uk NWW.jba-bentley.co.uk	SCALE 1:50 C02.1 MORTAR SPEC REVISED 11.07.23 AB ET ET C01 FOR CONSTRUCTION 07.06.23 AB DP ET P01.3 AMENDED TO REFLECT EXISTING CONCRETE PROFILE & CONCRETE FILL LEVELS 30.03.23 AB AB DR Image: Concrete Fill Levels 25.11.22 AB AB DR Image: Concrete Fill Levels Image: Concrete Fill Levels 20.10.22 AB AB DR Image: Concrete Fill Levels Image: Concrete Fill Levels </th <th></th> <th></th> <th></th> <th></th> <th></th> <th></th> <th></th>							
SCALE 1:50 C02.1 MORTAR SPEC REVISED 11.07.23 AB ET ET ET C01 FOR CONSTRUCTION 07.06.23 AB DP ET Image: Construction of the second	SCALE 1:50 C02.1 MORTAR SPEC REVISED 11.07.23 AB ET ET C01 FOR CONSTRUCTION 07.06.23 AB DP ET P01.3 AMENDED TO REFLECT EXISTING CONCRETE PROFILE & CONCRETE FILL LEVELS 30.03.23 AB AB DR DR P01.2 FILL MATERIAL CHANGE 25.11.22 AB AB DR DR P01.1 PRELIMINARY DESIGN STAGE 20.10.22 AB AB O I Rev. Description Date Author Designer Checker I Document Control JBA BECITIE N Street, Leeds, Leeds, LST 2HL Street, Leeds, Leeds, LST 2HL LST 2HL T +44 (0)113 426 8536 E info@jba-bentley.co.uk NWW.jba-bentley.co.uk	SCALE 1:50 C02.1 MORTAR SPEC REVISED 11.07.23 AB ET ET C01 FOR CONSTRUCTION 07.06.23 AB DP ET P01.3 AMENDED TO REFLECT EXISTING CONCRETE PROFILE & CONCRETE FILL LEVELS 30.03.23 AB AB DR Image: Concrete Fill Levels 25.11.22 AB AB DR Image: Concrete Fill Levels Image: Concrete Fill Levels 20.10.22 AB AB DR Image: Concrete Fill Levels Image: Concrete Fill Levels </td <td></td> <td></td> <td></td> <td></td> <td></td> <td></td> <td></td>							
SCALE 1:50 C02.1 MORTAR SPEC REVISED 11.07.23 AB ET ET ET C01 FOR CONSTRUCTION 07.06.23 AB DP ET Image: Construction of the second	SCALE 1:50 C02.1 MORTAR SPEC REVISED 11.07.23 AB ET ET C01 FOR CONSTRUCTION 07.06.23 AB DP ET P01.3 AMENDED TO REFLECT EXISTING CONCRETE PROFILE & CONCRETE FILL LEVELS 30.03.23 AB AB DR DR P01.2 FILL MATERIAL CHANGE 25.11.22 AB AB DR DR P01.1 PRELIMINARY DESIGN STAGE 20.10.22 AB AB O I Rev. Description Date Author Designer Checker I Document Control JBA BECITIE N Street, Leeds, Leeds, LST 2HL Street, Leeds, Leeds, LST 2HL LST 2HL T +44 (0)113 426 8536 E info@jba-bentley.co.uk NWW.jba-bentley.co.uk	SCALE 1:50 C02.1 MORTAR SPEC REVISED 11.07.23 AB ET ET C01 FOR CONSTRUCTION 07.06.23 AB DP ET P01.3 AMENDED TO REFLECT EXISTING CONCRETE PROFILE & CONCRETE FILL LEVELS 30.03.23 AB AB DR Image: Concrete Fill Levels 25.11.22 AB AB DR Image: Concrete Fill Levels Image: Concrete Fill Levels 20.10.22 AB AB DR Image: Concrete Fill Levels Image: Concrete Fill Levels </th <th></th> <th></th> <th></th> <th></th> <th></th> <th></th> <th></th>							
SCALE 1:50 C02.1 MORTAR SPEC REVISED 11.07.23 AB ET ET ET C01 FOR CONSTRUCTION 07.06.23 AB DP ET 0 P01.3 AMENDED TO REFLECT EXISTING CONCRETE PROFILE & CONCRETE FILL LEVELS 30.03.23 AB AB DR 0 P01.2 FILL MATERIAL CHANGE 25.11.22 AB AB DR 0 P01.1 PRELIMINARY DESIGN STAGE 20.10.22 AB AB O 0 Rev. Description Date Author Designer Checker A Document Control JBA BENETICY 1st Floor, Bank House, 27 King Street, Leeds, LS1 2HL 11.326 8536 E Info@jba-bentley.co.uk	SCALE 1:50 C02.1 MORTAR SPEC REVISED 11.07.23 AB ET ET C01 FOR CONSTRUCTION 07.06.23 AB DP ET P01.3 AMENDED TO REFLECT EXISTING CONCRETE PROFILE & CONCRETE FILL LEVELS 30.03.23 AB AB DR DR P01.2 FILL MATERIAL CHANGE 25.11.22 AB AB DR DR P01.1 PRELIMINARY DESIGN STAGE 20.10.22 AB AB O I Rev. Description Date Author Designer Checker I Document Control JBA BECITIE N Street, Leeds, Leeds, LST 2HL Street, Leeds, Leeds, LST 2HL LST 2HL T +44 (0)113 426 8536 E info@jba-bentley.co.uk NWW.jba-bentley.co.uk	SCALE 1:50 C02.1 MORTAR SPEC REVISED 11.07.23 AB ET ET C01 FOR CONSTRUCTION 07.06.23 AB DP ET P01.3 AMENDED TO REFLECT EXISTING CONCRETE PROFILE & CONCRETE FILL LEVELS 30.03.23 AB AB DR Image: Concrete Fill Levels 25.11.22 AB AB DR Image: Checker Imag							
SCALE 1:50 C02.1 MORTAR SPEC REVISED 11.07.23 AB ET ET ET C01 FOR CONSTRUCTION 07.06.23 AB DP ET P P01.3 AMENDED TO REFLECT EXISTING CONCRETE PROFILE & CONCRETE FILL LEVELS 30.03.23 AB AB DR P P01.2 FILL MATERIAL CHANGE 25.11.22 AB AB DR P P01.1 PRELIMINARY DESIGN STAGE 20.10.22 AB AB DR P P01.1 PRELIMINARY DESIGN STAGE 20.10.22 AB AB DR P Document Control Date Author Designer Checker A Supplier	SCALE 1:50 C02.1 MORTAR SPEC REVISED 11.07.23 AB ET ET C01 FOR CONSTRUCTION 07.06.23 AB DP ET P01.3 AMENDED TO REFLECT EXISTING CONCRETE PROFILE & CONCRETE FILL LEVELS 30.03.23 AB AB DR DR P01.2 FILL MATERIAL CHANGE 25.11.22 AB AB DR DR P01.1 PRELIMINARY DESIGN STAGE 20.10.22 AB AB DR Image: Checker	SCALE 1:50 C02.1 MORTAR SPEC REVISED 11.07.23 AB ET ET C01 FOR CONSTRUCTION 07.06.23 AB DP ET P01.3 AMENDED TO REFLECT EXISTING CONCRETE PROFILE & CONCRETE FILL LEVELS 30.03.23 AB AB DR P01.2 FILL MATERIAL CHANGE 25.11.22 AB AB DR AB P01.1 PRELIMINARY DESIGN STAGE 20.10.22 AB AB DR AB Rev. Description Date Author Designer Checker AB Document Control JBA Bentley: 1st Floor, Bank House, 27 king Street, Leeds, LS1 2HL T +44 (0)113 426 8536 E info@jba-bentley.co.uk Street, Leeds, LS1 2HL Project Title Project Title Project Title Project Title							
SCALE 1:50 C02.1 MORTAR SPEC REVISED 11.07.23 AB ET ET ET C01 FOR CONSTRUCTION 07.06.23 AB DP ET P P01.3 AMENDED TO REFLECT EXISTING CONCRETE PROFILE & CONCRETE FILL LEVELS 30.03.23 AB AB DR P P01.2 FILL MATERIAL CHANGE 25.11.22 AB AB DR P P01.1 PRELIMINARY DESIGN STAGE 20.10.22 AB AB O P P01.1 PRELIMINARY DESIGN STAGE 20.10.22 AB AB O P Bocument Control Date Author Designer Checker A Supplier JBA BECITIENT 1st Floor, Bank House, 27 King Street, Leeds, LS1 2HL Stat 2HL T +44 (0)113 426 8536 E Info@jba-bentley.co.uk	SCALE 1:50 C02.1 MORTAR SPEC REVISED 11.07.23 AB ET ET C01 FOR CONSTRUCTION 07.06.23 AB DP ET P01.3 AMENDED TO REFLECT EXISTING CONCRETE PROFILE & CONCRETE FILL LEVELS 30.03.23 AB AB DR DR P01.2 FILL MATERIAL CHANGE 25.11.22 AB AB DR DR P01.1 PRELIMINARY DESIGN STAGE 20.10.22 AB AB DR I Rev. Description Date Author Designer Checker I Document Control JBA BECITIE N Street, Leeds, LS1 2HL T +44 (0)113 426 8536 LS1 2HL T +44 (0)113 426 8536 E info@jba-bentley.co.uk	SCALE 1:50 C02.1 MORTAR SPEC REVISED 11.07.23 AB ET ET C01 FOR CONSTRUCTION 07.06.23 AB DP ET P01.3 AMENDED TO REFLECT EXISTING CONCRETE PROFILE & CONCRETE FILL LEVELS 30.03.23 AB AB DR P01.2 FILL MATERIAL CHANGE 25.11.22 AB AB DR Image: Checker A P01.1 PRELIMINARY DESIGN STAGE 20.10.22 AB AB DR Image: Checker A Document Control Date Author Designer Checker A Supplier Ist Floor, Bank House, 27 king Street, Leeds, LS1 2HL T +44 (0)113 426 8536 E info@jba-bentley.co.uk Project Title							
SCALE 1:50 C02.1 MORTAR SPEC REVISED 11.07.23 AB ET ET ET C01 FOR CONSTRUCTION 07.06.23 AB DP ET P P01.3 AMENDED TO REFLECT EXISTING CONCRETE PROFILE & CONCRETE FILL LEVELS 30.03.23 AB AB DR P P01.2 FILL MATERIAL CHANGE 25.11.22 AB AB DR P P01.1 PRELIMINARY DESIGN STAGE 20.10.22 AB AB O P P01.1 PRELIMINARY DESIGN STAGE 20.10.22 AB AB O P Bocument Control Date Author Designer Checker A Supplier JBA BECITIENT 1st Floor, Bank House, 27 King Street, Leeds, LS1 2HL Stat 2HL T +44 (0)113 426 8536 E Info@jba-bentley.co.uk	SCALE 1:50 C02.1 MORTAR SPEC REVISED 11.07.23 AB ET ET C01 FOR CONSTRUCTION 07.06.23 AB DP ET P01.3 AMENDED TO REFLECT EXISTING CONCRETE PROFILE & CONCRETE FILL LEVELS 30.03.23 AB AB DR DR P01.2 FILL MATERIAL CHANGE 25.11.22 AB AB DR DR P01.1 PRELIMINARY DESIGN STAGE 20.10.22 AB AB DR I Rev. Description Date Author Designer Checker I Document Control JBA BECITIE N Street, Leeds, LS1 2HL T +44 (0)113 426 8536 LS1 2HL T +44 (0)113 426 8536 E info@jba-bentley.co.uk	SCALE 1:50 C02.1 MORTAR SPEC REVISED 11.07.23 AB ET ET C01 FOR CONSTRUCTION 07.06.23 AB DP ET P01.3 AMENDED TO REFLECT EXISTING CONCRETE PROFILE & CONCRETE FILL LEVELS 30.03.23 AB AB DR P01.2 FILL MATERIAL CHANGE 25.11.22 AB AB DR Image: Checker A P01.1 PRELIMINARY DESIGN STAGE 20.10.22 AB AB DR Image: Checker A Document Control Date Author Designer Checker A Supplier Ist Floor, Bank House, 27 king Street, Leeds, LS1 2HL T +44 (0)113 426 8536 E info@jba-bentley.co.uk Project Title							
SCALE 1:50 C02.1 MORTAR SPEC REVISED 11.07.23 AB ET ET ET C01 FOR CONSTRUCTION 07.06.23 AB DP ET P P01.3 AMENDED TO REFLECT EXISTING CONCRETE PROFILE & CONCRETE FILL LEVELS 30.03.23 AB AB DR P P01.2 FILL MATERIAL CHANGE 25.11.22 AB AB DR P P01.1 PRELIMINARY DESIGN STAGE 20.10.22 AB AB O P P01.1 PRELIMINARY DESIGN STAGE 20.10.22 AB AB O P Bocument Control Date Author Designer Checker A Supplier JBA BECITIENT 1st Floor, Bank House, 27 King Street, Leeds, LS1 2HL Stat 2HL T +44 (0)113 426 8536 E Info@jba-bentley.co.uk	SCALE 1:50 C02.1 MORTAR SPEC REVISED 11.07.23 AB ET ET C01 FOR CONSTRUCTION 07.06.23 AB DP ET P01.3 AMENDED TO REFLECT EXISTING CONCRETE PROFILE & CONCRETE FILL LEVELS 30.03.23 AB AB DR DR P01.2 FILL MATERIAL CHANGE 25.11.22 AB AB DR DR P01.1 PRELIMINARY DESIGN STAGE 20.10.22 AB AB DR I Rev. Description Date Author Designer Checker I Document Control JBA BECITIE N Street, Leeds, LS1 2HL T +44 (0)113 426 8536 LS1 2HL T +44 (0)113 426 8536 E info@jba-bentley.co.uk	SCALE 1:50 C02.1 MORTAR SPEC REVISED 11.07.23 AB ET ET C01 FOR CONSTRUCTION 07.06.23 AB DP ET P01.3 AMENDED TO REFLECT EXISTING CONCRETE PROFILE & CONCRETE FILL LEVELS 30.03.23 AB AB DR P01.2 FILL MATERIAL CHANGE 25.11.22 AB AB DR PO P01.1 PRELIMINARY DESIGN STAGE 20.10.22 AB AB DR PO Rev. Description Date Author Designer Checker A Document Control JBA Bentley (A Leeds, LS1 2HL T +44 (0)113 426 8536 E info@jba-bentley.co.uk LS1 2HL T +44 (0)113 426 8536 E info@jba-bentley.co.uk Www.jba-bentley.co.uk Project Title Project Title Fright A Fright A </th <th></th> <th></th> <th></th> <th></th> <th></th> <th></th> <th></th>							
SCALE 1:50 C02.1 MORTAR SPEC REVISED 11.07.23 AB ET ET ET C01 FOR CONSTRUCTION 07.06.23 AB DP ET P P01.3 AMENDED TO REFLECT EXISTING CONCRETE PROFILE & CONCRETE FILL LEVELS 30.03.23 AB AB DR P P01.2 FILL MATERIAL CHANGE 25.11.22 AB AB DR P P01.1 PRELIMINARY DESIGN STAGE 20.10.22 AB AB O P P01.1 PRELIMINARY DESIGN STAGE 20.10.22 AB AB O P Bocument Control Date Author Designer Checker A Supplier JBA BECITIENT 1st Floor, Bank House, 27 King Street, Leeds, LS1 2HL Stat 2HL T +44 (0)113 426 8536 E Info@jba-bentley.co.uk	SCALE 1:50 C02.1 MORTAR SPEC REVISED 11.07.23 AB ET ET C01 FOR CONSTRUCTION 07.06.23 AB DP ET P01.3 AMENDED TO REFLECT EXISTING CONCRETE PROFILE & CONCRETE FILL LEVELS 30.03.23 AB AB DR DR P01.2 FILL MATERIAL CHANGE 25.11.22 AB AB DR DR P01.1 PRELIMINARY DESIGN STAGE 20.10.22 AB AB DR I Rev. Description Date Author Designer Checker I Document Control JBA BECITIE N Street, Leeds, LS1 2HL T +44 (0)113 426 8536 LS1 2HL T +44 (0)113 426 8536 E info@jba-bentley.co.uk	SCALE 1:50 C02.1 MORTAR SPEC REVISED 11.07.23 AB ET ET C01 FOR CONSTRUCTION 07.06.23 AB DP ET P01.3 AMENDED TO REFLECT EXISTING CONCRETE PROFILE & CONCRETE FILL LEVELS 30.03.23 AB AB DR P01.2 FILL MATERIAL CHANGE 25.11.22 AB AB DR PO P01.1 PRELIMINARY DESIGN STAGE 20.10.22 AB AB DR PO Rev. Description Date Author Designer Checker A Document Control JBA Bentley (A Leeds, LS1 2HL T +44 (0)113 426 8536 E info@jba-bentley.co.uk LS1 2HL T +44 (0)113 426 8536 E info@jba-bentley.co.uk Www.jba-bentley.co.uk Project Title Project Title Fright A Fright A </th <th></th> <th></th> <th></th> <th></th> <th></th> <th></th> <th></th>							
SCALE 1:50 C02.1 MORTAR SPEC REVISED 11.07.23 AB ET ET ET C01 FOR CONSTRUCTION 07.06.23 AB DP ET 0 P01.3 AMENDED TO REFLECT EXISTING CONCRETE PROFILE & CONCRETE FILL LEVELS 30.03.23 AB AB DR 0 P01.2 FILL MATERIAL CHANGE 25.11.22 AB AB DR 0 P01.1 PRELIMINARY DESIGN STAGE 20.10.22 AB AB O 0 Rev. Description Date Author Designer Checker A Document Control JBA BENETICY 1st Floor, Bank House, 27 King Street, Leeds, LS1 2HL 11.326 8536 E Info@jba-bentley.co.uk	SCALE 1:50 C02.1 MORTAR SPEC REVISED 11.07.23 AB ET ET C01 FOR CONSTRUCTION 07.06.23 AB DP ET P01.3 AMENDED TO REFLECT EXISTING CONCRETE PROFILE & CONCRETE FILL LEVELS 30.03.23 AB AB DR DR P01.2 FILL MATERIAL CHANGE 25.11.22 AB AB DR DR P01.1 PRELIMINARY DESIGN STAGE 20.10.22 AB AB O I Rev. Description Date Author Designer Checker I Document Control JBA BECITIE N Street, Leeds, Leeds, LST 2HL Street, Leeds, Leeds, LST 2HL LST 2HL T +44 (0)113 426 8536 E info@jba-bentley.co.uk NWW.jba-bentley.co.uk	SCALE 1:50 C02.1 MORTAR SPEC REVISED 11.07.23 AB ET ET C01 FOR CONSTRUCTION 07.06.23 AB DP ET P01.3 AMENDED TO REFLECT EXISTING CONCRETE PROFILE & CONCRETE FILL LEVELS 30.03.23 AB AB DR Image: Concrete Fill Levels 25.11.22 AB AB DR Image: Checker Imag							
C02.1 MORTAR SPEC REVISED 11.07.23 AB ET ET ET C01 FOR CONSTRUCTION 07.06.23 AB DP ET PT P01.3 AMENDED TO REFLECT EXISTING CONCRETE PROFILE & CONCRETE FILL LEVELS 30.03.23 AB AB DR PT P01.2 FILL MATERIAL CHANGE 25.11.22 AB AB DR PT P01.1 PRELIMINARY DESIGN STAGE 20.10.22 AB AB DR PT PO1.1 PRELIMINARY DESIGN STAGE 20.10.22 AB AB DR PT Document Control Date Author Designer Checker A	C02.1 MORTAR SPEC REVISED 11.07.23 AB ET ET C01 FOR CONSTRUCTION 07.06.23 AB DP ET P01.3 AMENDED TO REFLECT EXISTING CONCRETE PROFILE & CONCRETE FILL LEVELS 30.03.23 AB AB DR P01.2 FILL MATERIAL CHANGE 25.11.22 AB AB DR PR P01.1 PRELIMINARY DESIGN STAGE 20.10.22 AB AB DR PR Rev. Description Date Author Designer Checker A Document Control Supplier Ist Floor, Bank House, 27 King Street, Leeds, LS1 2HL 1st Floor, 37 King Street, Leeds, LS1 2HL 144 (0)113 426 8536 E Info@jba-bentley.co.uk	C02.1 MORTAR SPEC REVISED 11.07.23 AB ET ET I C01 FOR CONSTRUCTION 07.06.23 AB DP ET I P01.3 AMENDED TO REFLECT EXISTING CONCRETE PROFILE & CONCRETE FILL LEVELS 30.03.23 AB AB DR I P01.2 FILL MATERIAL CHANGE 25.11.22 AB AB DR I P01.1 PRELIMINARY DESIGN STAGE 20.10.22 AB AB I I Rev. Description Date Author Designer Checker A Document Control JBA Bentley: Ist Floor, Bank House, 27 King Street, Leeds, LS1 2HL T +44 (0)113 426 8536 E info@lba-bentley.co.uk VWW.jba-bentley.co.uk WWW.jba-bentley.co.uk Project Title Project Title File File File							
COIN FOR CONSTRUCTION 07.06.23 AB DP ET P01.3 AMENDED TO REFLECT EXISTING CONCRETE PROFILE & CONCRETE FILL LEVELS 30.03.23 AB AB DR P01.2 FILL MATERIAL CHANGE 25.11.22 AB AB DR P01.1 PRELIMINARY DESIGN STAGE 20.10.22 AB AB DR Rev. Description Date Author Designer Checker A Document Control JBA BEENTLEYY Ist Floor, Bank House, 27 King Street, Leeds, LS1 2HL T +44 (0)113 426 8536 E info@jba-bentley.co.uk	COLINMONINAL DE CALINELMONINEMONINELinLinLinCO1FOR CONSTRUCTION07.06.23ABDPETP01.3AMENDED TO REFLECT EXISTING CONCRETE PROFILE & CONCRETE FILL LEVELS30.03.23ABABDRP01.2FILL MATERIAL CHANGE25.11.22ABABDRIP01.1PRELIMINARY DESIGN STAGE20.10.22ABABDRIRev.DescriptionDateAuthorDesignerCheckerIDocument ControlIst Floor, Bank House, 27 King Street, Leeds, LS1 2HLStreet, Leeds, LS1 2HLStreet, Leeds, LS1 2HLStreet, Leeds, LS1 2HLStreet, Leeds, LS1 2HL	CO1 FOR CONSTRUCTION 07.06.23 AB DP ET P01.3 AMENDED TO REFLECT EXISTING CONCRETE PROFILE & CONCRETE FILL LEVELS 30.03.23 AB AB DR P01.2 FILL MATERIAL CHANGE 25.11.22 AB AB DR PO P01.1 PRELIMINARY DESIGN STAGE 20.10.22 AB AB DR PO Rev. Description Date Author Designer Checker A Document Control Bank House, 27 King Street, Leeds, LS1 2HL T state 8536 State 8536 E info@jba-bentley.co.uk				1	2	3m	
P01.3 AMENDED TO REFLECT EXISTING CONCRETE PROFILE & CONCRETE FILL LEVELS 30.03.23 AB AB DR P01.2 FILL MATERIAL CHANGE 25.11.22 AB AB DR P01.1 PRELIMINARY DESIGN STAGE 20.10.22 AB AB AB Image: Checker A P01.1 PRELIMINARY DESIGN STAGE Date Author Designer Checker A Rev. Description Date Author Designer Checker A Document Control Bank House, 27 King Street, Leeds, LS1 2HL T +44 (0)113 426 8536 S1 2HL T +44 (0)113 426 8536 T +44 (0)113 426 8536	P01.3 AMENDED TO REFLECT EXISTING CONCRETE PROFILE & CONCRETE FILL LEVELS 30.03.23 AB AB DR P01.2 FILL MATERIAL CHANGE 25.11.22 AB AB DR PO P01.1 PRELIMINARY DESIGN STAGE 20.10.22 AB AB DR PO P01.1 PRELIMINARY DESIGN STAGE 20.10.22 AB AB DR PO Rev. Description Date Author Designer Checker PO Document Control Date Author Designer Checker PO	P01.3 AMENDED TO REFLECT EXISTING CONCRETE PROFILE & CONCRETE FILL LEVELS 30.03.23 AB AB DR P01.2 FILL MATERIAL CHANGE 25.11.22 AB AB DR AB P01.1 PRELIMINARY DESIGN STAGE 20.10.22 AB AB AB AB AB Rev. Description Date Author Designer Checker A Document Control JBA Bentley N 1st Floor, Bank House, 27 King Street, Leeds, LS1 2HL 1st Floor, 1 +44 (0)113 426 8536 Leeds, E info@jba-bentley.co.uk Project Title Project Title Project Title Project Title Project Title		SCAL	E 1:50				
Initial Constraint of the levels Initial Constraint of the levels Initial Constraint of the levels P01.2 FILL MATERIAL CHANGE 25.11.22 AB AB DR P01.1 PRELIMINARY DESIGN STAGE 20.10.22 AB AB Initial Checker AB Rev. Description Date Author Designer Checker AB Document Control Date Author Designer Checker AB Supplier JBA Bentley 🏹 Ist Floor, Bank House, 27 King Street, Leeds, LS1 2HL T +44 (0)113 426 8536 E info@jba-bentley.co.uk	Image: Second Problem P	Number of the state of the		MORTAR SPEC REVISED	LE 1:50	AB	ET	ET	
PO1.1 PRELIMINARY DESIGN STAGE 20.10.22 AB AB AB Rev. Description Date Author Designer Checker A Document Control Ist Floor, Bank House, 27 King Street, Leeds, LS1 2HL T +44 (0)113 426 8536 E info@jba-bentley.co.uk	PO1.1 PRELIMINARY DESIGN STAGE 20.10.22 AB AB Image: Checker of the constraints of the constraint	PO1.1 PRELIMINARY DESIGN STAGE 20.10.22 AB AB AB Rev. Description Date Author Designer Checker A Document Control Supplier JBA Ist Floor, Bank House, 27 King Street, Leeds, LS1 2HL T +44 (0)113 426 8536 E info@jba-bentley.co.uk WWV.jba-bentley.co.uk Project Title Project	CO1	SCAL MORTAR SPEC REVISED FOR CONSTRUCTION AMENDED TO REFLECT EXISTING	E 1:50 11.07.23 07.06.23	AB	ET	ET	
Rev. Description Date Author Designer Checker A Document Control	Rev. Description Date Author Designer Checker Author Document Control Supplier 1st Floor, Bank House, 27 King Street, Leeds, LS1 2HL T +44 (0)113 426 8536 E info@jba-bentley.co.uk T +44 (0)113 426 8536	Rev. Description Date Author Designer Checker A Document Control	CO1	SCAL MORTAR SPEC REVISED FOR CONSTRUCTION AMENDED TO REFLECT EXISTING CONCRETE PROFILE & CONCRETE FILL LEVELS	E 1:50 11.07.23 07.06.23	AB	ET	ET	
Supplier JBA Bentley in the second se	Supplier JBA Bentley * Ist Floor, Bank House, 27 King Street, Leeds, LS1 2HL T +44 (0)113 426 8536 E info@jba-bentley.co.uk www.jba-bentley.co.uk	Supplier 1st Floor, Bank House, 27 King Street, Leeds, LS1 2HL T +44 (0)113 426 8536 E info@jba-bentley.co.uk Project Title	CO1 P01.3 P01.2	SCAL MORTAR SPEC REVISED FOR CONSTRUCTION AMENDED TO REFLECT EXISTING CONCRETE PROFILE & CONCRETE FILL LEVELS FILL MATERIAL CHANGE	E 1:50 11.07.23 07.06.23 30.03.23 25.11.22	AB AB AB AB	ET DP AB AB	ET ET DR	
JBA Bentley (1) Bank House, 27 King Street, Leeds, LS1 2HL T +44 (0)113 426 8536 E info@jba-bentley.co.uk	JBA Bentley Street, Leeds, LS1 2HL T +44 (0)113 426 8536 E info@jba-bentley.co.uk www.jba-bentley.co.uk	JBA Bentley States, Leeds, LS1 2HL T +44 (0)113 426 8536 E info@jba-bentley.co.uk Www.jba-bentley.co.uk	CO1 P01.3 P01.2 PO1.1	SCAL MORTAR SPEC REVISED FOR CONSTRUCTION AMENDED TO REFLECT EXISTING CONCRETE PROFILE & CONCRETE FILL LEVELS FILL MATERIAL CHANGE PRELIMINARY DESIGN STAGE	E 1:50 11.07.23 07.06.23 30.03.23 25.11.22 20.10.22	AB AB AB AB AB	ET DP AB AB AB	ET ET DR DR	
T +44 (0)113 426 8536 E info@jba-bentley.co.uk	T +44 (0)113 426 8536 E info@jba-bentley.co.uk www.jba-bentley.co.uk	Project Title	CO1 P01.3 P01.2 PO1.1 Rev. Docume	SCAL MORTAR SPEC REVISED FOR CONSTRUCTION AMENDED TO REFLECT EXISTING CONCRETE PROFILE & CONCRETE FILL LEVELS FILL MATERIAL CHANGE PRELIMINARY DESIGN STAGE Description nt Control	E 1:50 11.07.23 07.06.23 30.03.23 25.11.22 20.10.22	AB AB AB AB AB Author	ET DP AB AB AB AB Designer	ET ET DR DR	
E info@jba-bentley.co.uk	E info@jba-bentley.co.uk www.jba-bentley.co.uk	E info@jba-bentley.co.uk www.jba-bentley.co.uk	CO1 P01.3 P01.2 PO1.1 Rev. Docume	SCAL MORTAR SPEC REVISED FOR CONSTRUCTION AMENDED TO REFLECT EXISTING CONCRETE PROFILE & CONCRETE FILL LEVELS FILL MATERIAL CHANGE PRELIMINARY DESIGN STAGE Description nt Control	LE 1:50 11.07.23 07.06.23 30.03.23 25.11.22 20.10.22 Date	AB AB AB AB AB Author	ET DP AB AB AB AB Designer	ET ET DR DR Checker	
	Project Title		CO1 P01.3 P01.2 PO1.1 Rev. Docume	SCAL MORTAR SPEC REVISED FOR CONSTRUCTION AMENDED TO REFLECT EXISTING CONCRETE PROFILE & CONCRETE FILL LEVELS FILL MATERIAL CHANGE PRELIMINARY DESIGN STAGE Description nt Control	LE 1:50 11.07.23 07.06.23 30.03.23 25.11.22 20.10.22 Date	AB AB AB AB AB Author	ET DP AB AB AB Designer st Floor, ank House, 7 King Street, eeds, S1 2HL	ET ET DR DR Checker	
DON REGULATORS - MEADOWGATE			CO1 P01.3 P01.2 PO1.1 Rev. Docume	SCAL MORTAR SPEC REVISED FOR CONSTRUCTION AMENDED TO REFLECT EXISTING CONCRETE PROFILE & CONCRETE FILL LEVELS FILL MATERIAL CHANGE PRELIMINARY DESIGN STAGE Description nt Control	LE 1:50 11.07.23 07.06.23 30.03.23 25.11.22 20.10.22 Date	AB AB AB AB AB AUthor	ET DP AB AB AB Designer st Floor, ank House, 7 King Street, eeds, S1 2HL +44 (0)113 4 info@jba-bentle	ET ET DR DR Checker	
DON REGULATORS - MEADOWGATE		Drawing Title	CO1 P01.3 P01.2 PO1.1 Rev. Docume Supplie	SCAL MORTAR SPEC REVISED FOR CONSTRUCTION AMENDED TO REFLECT EXISTING CONCRETE PROFILE & CONCRETE FILL LEVELS FILL MATERIAL CHANGE DESCRIPTION IN CONTROL JBA BEDITION TITLE DON REGULATOR	LE 1:50 11.07.23 07.06.23 30.03.23 25.11.22 20.10.22 Date	AB AB AB AB AB AUthor	ET DP AB AB AB Designer st Floor, ank House, 7 King Street, eeds, S1 2HL +44 (0)113 4 info@jba-bentle	ET ET DR DR Checker	
	Drawing Title		CO1 P01.3 P01.2 PO1.1 Rev. Docume Supplie	SCAL MORTAR SPEC REVISED FOR CONSTRUCTION AMENDED TO REFLECT EXISTING CONCRETE PROFILE & CONCRETE FILL LEVELS FILL MATERIAL CHANGE PRELIMINARY DESIGN STAGE Description nt Control TUBA BEENTION TITLE TITLE	LE 1:50 11.07.23 07.06.23 30.03.23 25.11.22 20.10.22 Date C	AB AB AB AB AB Author	ET DP AB AB AB Designer St Floor, ank House, 7 King Street, eeds, S1 2HL +44 (0)113 4 info@jba-bentle WW.jba-bentle	ET ET DR DR Checker	
Drawing Title	Drawing Title MEADOWGATE FISH PASS	MEADOWGATE FISH PASS	CO1 P01.3 P01.2 PO1.1 Rev. Docume Supplie	SCAL MORTAR SPEC REVISED FOR CONSTRUCTION AMENDED TO REFLECT EXISTING CONCRETE PROFILE & CONCRETE FILL LEVELS FILL MATERIAL CHANGE PRELIMINARY DESIGN STAGE Description nt Control JBA BEENTION TITLE TITLE MEADOWGA	LE 1:50 11.07.23 07.06.23 30.03.23 25.11.22 20.10.22 Date CS - M	AB AB AB AB AB Author	ET DP AB AB AB Designer St Floor, ank House, 7 King Street, eeds, S1 2HL +44 (0)113 4 info@jba-bentle WW.jba-bentle DOW(DOW(ET ET DR DR Checker	
Drawing Title MEADOWGATE FISH PASS	Drawing Title MEADOWGATE FISH PASS	MEADOWGATE FISH PASS	CO1 P01.3 P01.2 PO1.1 Rev. Docume Supplie	SCAL MORTAR SPEC REVISED FOR CONSTRUCTION AMENDED TO REFLECT EXISTING CONCRETE PROFILE & CONCRETE FILL LEVELS FILL MATERIAL CHANGE PRELIMINARY DESIGN STAGE Description nt Control JBA BEENTION TITLE TITLE MEADOWGA	LE 1:50 11.07.23 07.06.23 30.03.23 25.11.22 20.10.22 Date CS - M	AB AB AB AB AB Author	ET DP AB AB AB Designer St Floor, ank House, 7 King Street, eeds, S1 2HL +44 (0)113 4 info@jba-bentle WW.jba-bentle DOW(DOW(ET ET DR DR Checker	
Drawing Title MEADOWGATE FISH PASS CROSS SECTIONS	Drawing Title MEADOWGATE FISH PASS CROSS SECTIONS	MEADOWGATE FISH PASS CROSS SECTIONS	CO1 P01.3 P01.2 PO1.1 Rev. Docume Supplie	SCAL MORTAR SPEC REVISED FOR CONSTRUCTION AMENDED TO REFLECT EXISTING CONCRETE PROFILE & CONCRETE FILL LEVELS FILL MATERIAL CHANGE PRELIMINARY DESIGN STAGE Description nt Control JBA Bentle JBA Bentle Title DON REGULATOR	E 1:50 11.07.23 07.06.23 25.11.22 20.10.22 Date CS - M S - M	AB AB AB AB AB AUTHOR 11 B 2 L L L L L L L L L L L L L L L L L L	ET DP AB AB AB Designer St Floor, ank House, 7 King Street, eeds, S1 2HL +44 (0)113 4 info@jba-ben ww.jba-bentle DOWO	ET ET DR DR Checker	
Drawing Title MEADOWGATE FISH PASS CROSS SECTIONS	Drawing Title MEADOWGATE FISH PASS CROSS SECTIONS	MEADOWGATE FISH PASS CROSS SECTIONS	CO1 P01.3 P01.2 PO1.1 Rev. Docume Supplie	SCAL MORTAR SPEC REVISED FOR CONSTRUCTION AMENDED TO REFLECT EXISTING CONCRETE PROFILE & CONCRETE FILL LEVELS FILL MATERIAL CHANGE PRELIMINARY DESIGN STAGE Description nt Control JBA Bentle JBA Bentle Title DON REGULATOR	E 1:50 11.07.23 07.06.23 25.11.22 20.10.22 Date CS - M S - M	AB AB AB AB AB AUTHOR 11 B 2 L L L L L L L L L L L L L L L L L L	ET DP AB AB AB Designer St Floor, ank House, 7 King Street, eeds, S1 2HL +44 (0)113 4 info@jba-ben ww.jba-bentle DOWO	ET ET DR DR Checker	
Drawing Title MEADOWGATE FISH PASS	Drawing Title MEADOWGATE FISH PASS CROSS SECTIONS Environment Agency	MEADOWGATE FISH PASS CROSS SECTIONS	CO1 P01.3 P01.2 PO1.1 Rev. Docume Supplies	SCAL MORTAR SPEC REVISED FOR CONSTRUCTION AMENDED TO REFLECT EXISTING CONCRETE PROFILE & CONCRETE FILL LEVELS FILL MATERIAL CHANGE PRELIMINARY DESIGN STAGE Description Int Control JBA Bentle JBA Bentle Title DON REGULATOR	E 1:50 11.07.23 07.06.23 25.11.22 20.10.22 Date CS - M S - M	AB AB AB AB AB AUTHOR 11 B 2 L L L L L L L L L L L L L L L L L L	ET DP AB AB AB Designer St Floor, ank House, 7 King Street, eeds, S1 2HL +44 (0)113 4 info@jba-ben ww.jba-bentle DOWO	ET ET DR DR Checker	
Drawing Title MEADOWGATE FISH PASS CROSS SECTIONS Environment Agency	Drawing Title MEADOWGATE FISH PASS CROSS SECTIONS Environment Agency @ copyright reserved Parent Model	MEADOWGATE FISH PASS CROSS SECTIONS Image: Comparison of the served Parent Model	CO1 P01.3 P01.2 PO1.1 Rev. Docume Supplie Project	SCAL MORTAR SPEC REVISED FOR CONSTRUCTION AMENDED TO REFLECT EXISTING CONCRETE PROFILE & CONCRETE FILL LEVELS FILL MATERIAL CHANGE PRELIMINARY DESIGN STAGE Description nt Control JBA Bentle JBA Bentle Title DON REGULATOR	E 1:50 11.07.23 07.06.23 25.11.22 20.10.22 Date CS - M S - M	AB AB AB AB AB AUTHOR 11 B 2 L L L L L L L L L L L L L L L L L L	ET DP AB AB AB Designer St Floor, ank House, 7 King Street, eeds, S1 2HL +44 (0)113 4 info@jba-ben ww.jba-bentle DOWO	ET ET DR DR Checker	
Drawing Title MEADOWGATE FISH PASS CROSS SECTIONS Environment Agency @ copyright reserved Parent Model NOT FROM MODEL Security Classification	Drawing Title MEADOWGATE FISH PASS CROSS SECTIONS Environment Agency @ copyright reserved Parent Model NOT FROM MODEL Security Classification	MEADOWGATE FISH PASS CROSS SECTIONS Security Classification	© copyr Porent I NOT F Security	SCAL MORTAR SPEC REVISED FOR CONSTRUCTION AMENDED TO REFLECT EXISTING CONCRETE PROFILE & CONCRETE FILL LEVELS FILL MATERIAL CHANGE PRELIMINARY DESIGN STAGE Description nt Control JBA Bentle JBA Bentle JBA Bentle Title MEADOWGASS CROSS S	E 1:50 11.07.23 07.06.23 30.03.23 25.11.22 20.10.22 Date CS - M CE FI SECT 7100 2000 CS - N		ET DP AB AB AB Designer St Floor, ank House, 7 King Street, eeds, S1 2HL +44 (0)113 4 info@jba-ben ww.jba-bentle DOWO	ET ET DR DR Checker	
Drawing Title MEADOWGATE FISH PASS CROSS SECTIONS Environment Agency @ copyright reserved Parent Model NOT FROM MODEL	Drawing Title Designer MEADOWGATE FISH PASS CROSS SECTIONS MEADOWGATE FISH PASS CROSS SECTIONS Designer Designer	MEADOWGATE FISH PASS CROSS SECTIONS Security Classification OFFICIAL Author Designer	© copyr Project 1 Project 1 Project 1 Project 1 Project 1 Project 1 Supplie	SCAL MORTAR SPEC REVISED FOR CONSTRUCTION AMENDED TO REFLECT EXISTING CONCRETE PROFILE & CONCRETE FILL LEVELS FILL MATERIAL CHANGE PRELIMINARY DESIGN STAGE Description nt Control JBA Bentle Title DON REGULATOR Title MEADOWGAS CROSS S MEADOWGAS CROSS S	E 1:50 11.07.23 07.06.23 30.03.23 25.11.22 20.10.22 Date Checker Checker		ET DP AB AB AB Designer st Floor, ank House, 7 King Street, eeds, 51 2HL +44 (0)113 4 info@jba-bentle ww.jba-bentle DOW(PASS S	ET ET DR DR Checker	

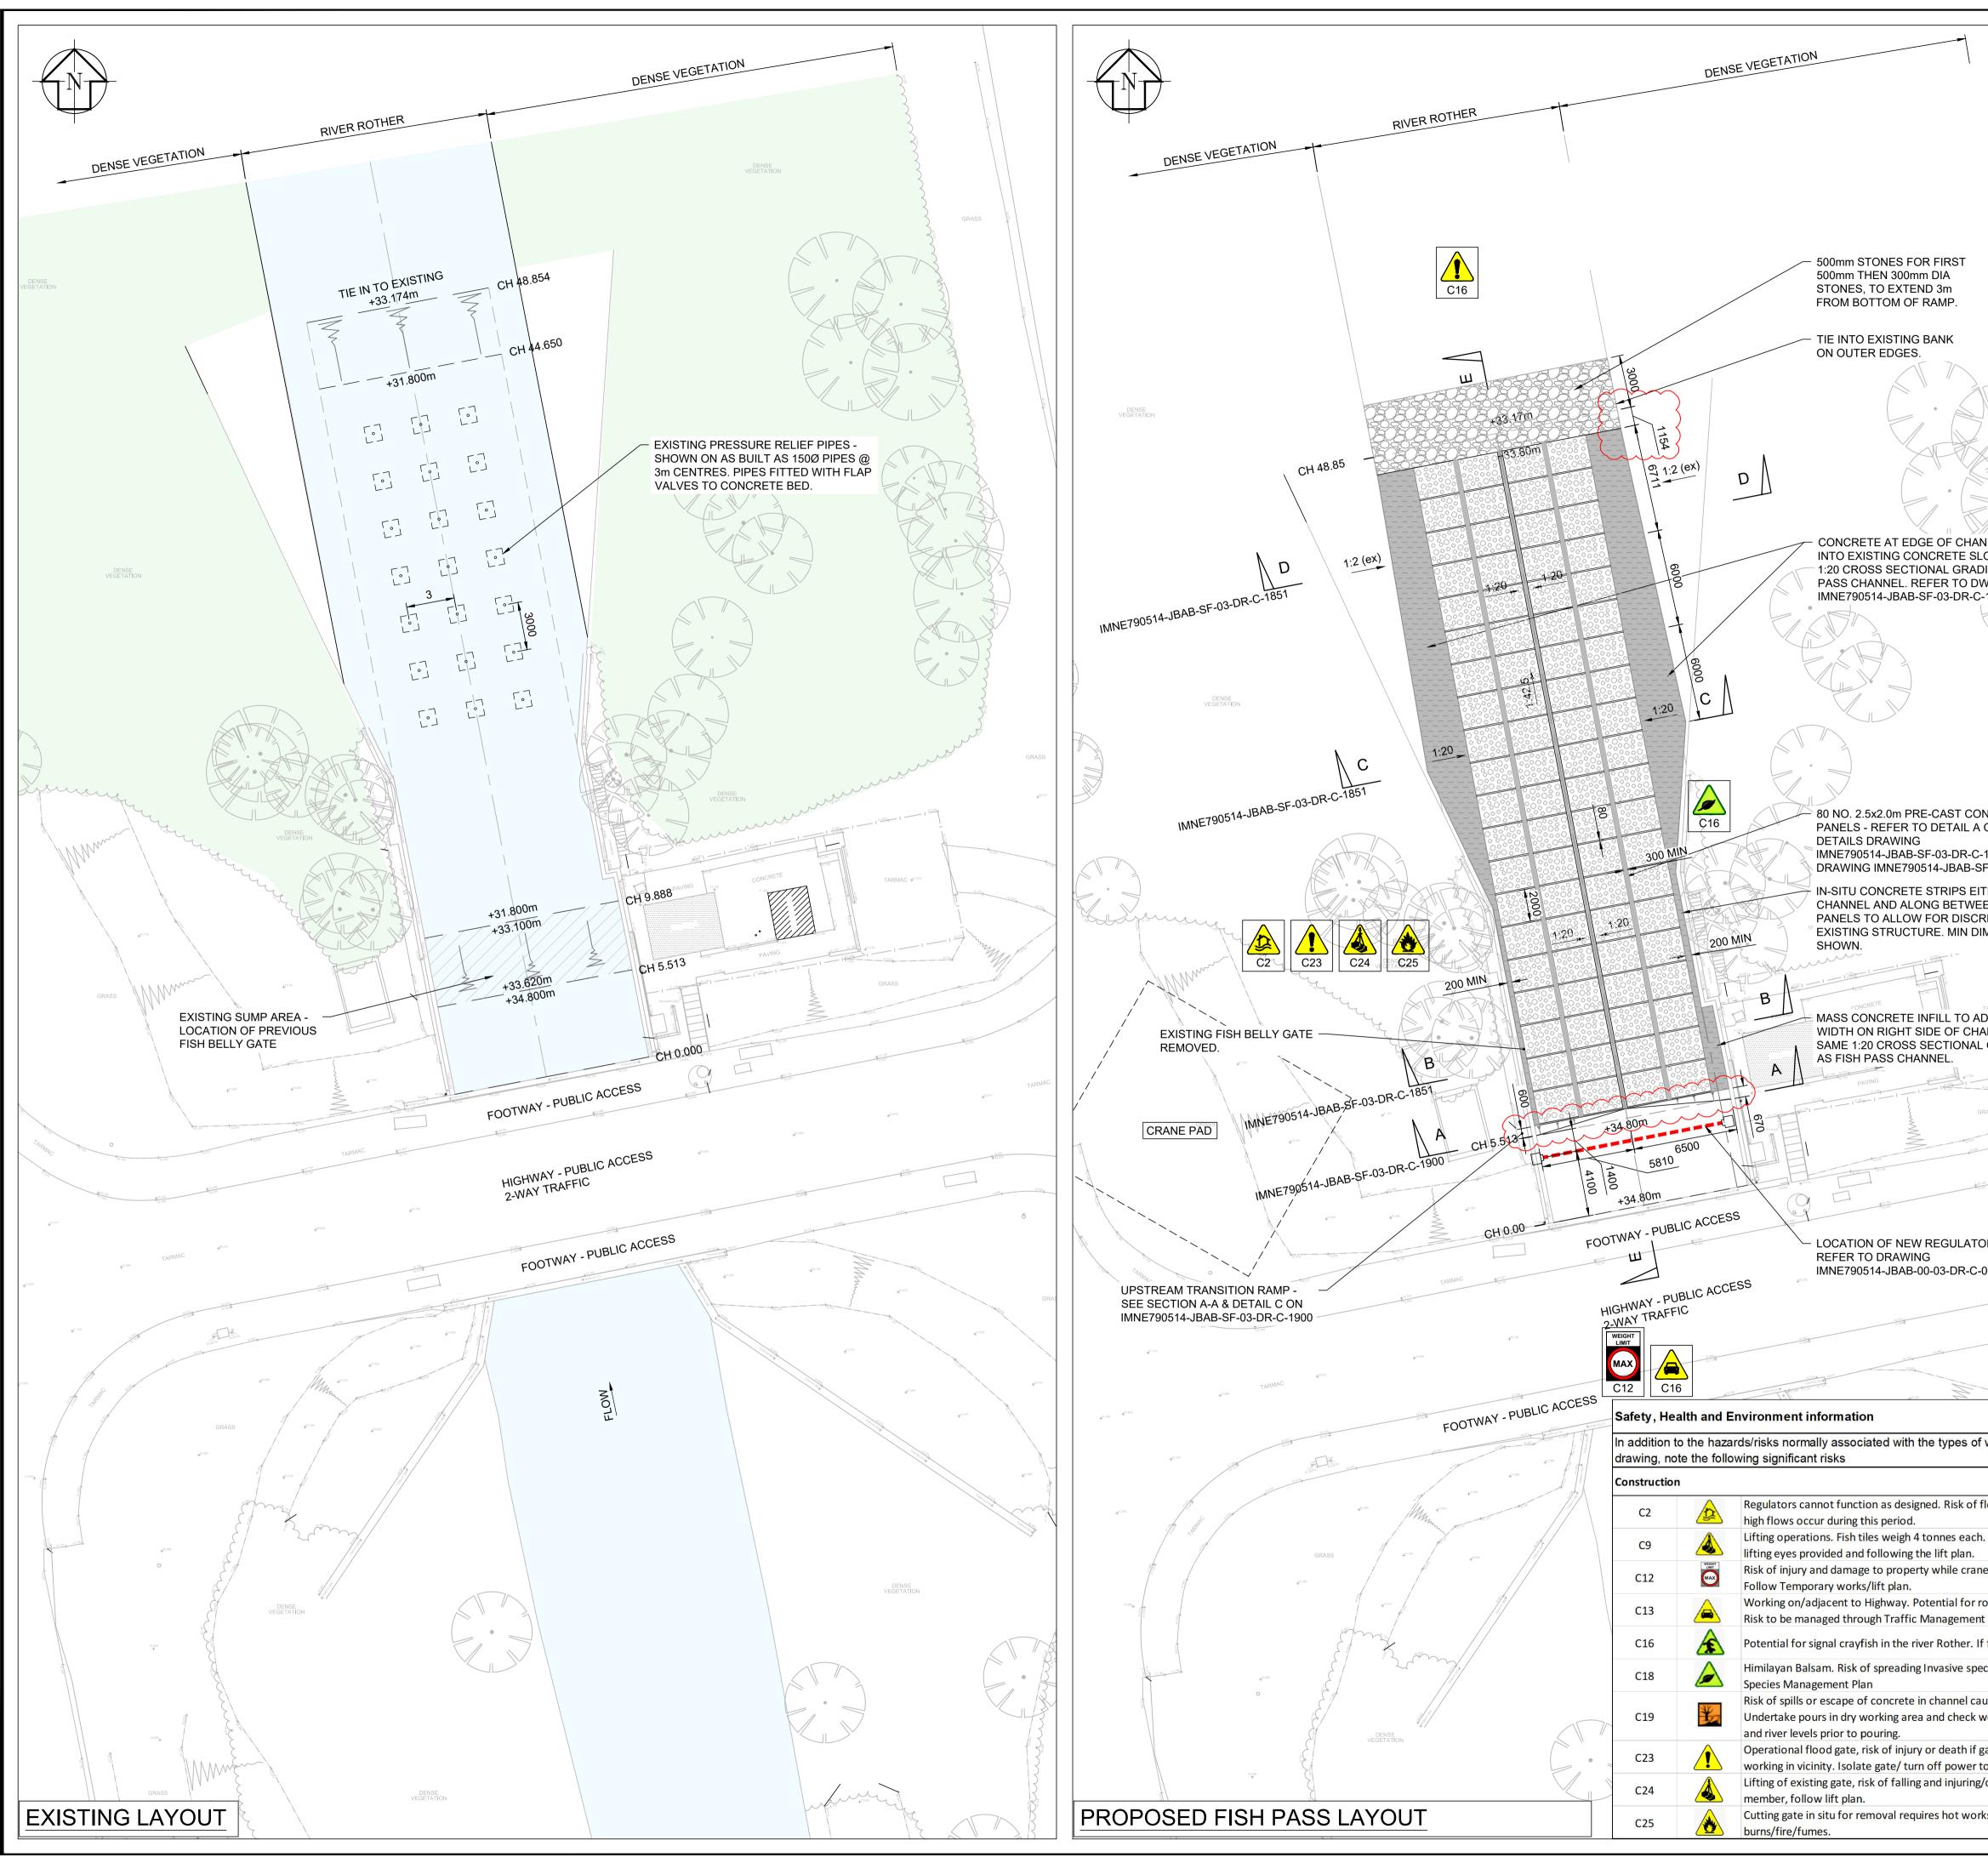

	-							
GRASS	1. A 2. A (r 3. A 4. D 5. A 6. T 5. A 6. T 5. A 6. T 8. A 9. T 6. T 5. S 8. A 9. T 6. T 5. S 6. T 5. S 6. T 5. S 6. T 5. S 6. T 7. S 7. S 7. S 7. S 7. S 7. S 7. S 7. S	LL LEVELS ARE mAOD) UNLESS LL COORDINAT ATIONAL GRID. O NOT SCALE F ERIFIED ON SIT NY DISCREPAN ESIGNER IMME HE ELECTRONI ETTING OUT ERVICES NOT S ERVICE LOCAT NVIMNE790514- LL VEGETATION ROPORTION FC OLERANCE FOF OR PRECAST U /ING TO BE REA 790514-JBAB-SF 790514-JBAB-SF 790514-JBAB-SF 790514-JBAB-SF 790514-JBAB-SF	CIES NOTED ON SITE	E TO ORD ELATIVE 1 ALL DIME ARE TO E ARE TO E DRAWING WING FOR ES, REFEI B. D BE REP ON OF WC ENT IS ±50 25mm. WITH THE PASS_COM PASS_COM PASS_COM PASS_COM PASS_COM PASS_COM	NANCE FO ORD ENSIONS BE REPC IS NOT 1 R HAZAR R TO DR PLACED DRKS Dmm, FO FOLLOW IG_SECT DSS_SEC DSS_SEC DSS_SEC DSS_SEC DSS_SEC DSS_SEC DSS_SEC DESS_PL PLAN OPS	DATUM N NANCE SI MUST B DRTED TO TO BE US DS AND O AWING WITH A 1 R CHANN VING DRA TIONS CTIONS TION_DE AN	IEWLYN JRVEY E CHECP D THE ED FOR CONSTR TO 5 IEL FALL WINGS: TAILS	AINTS, . 2%,
DNCRETE FISH PASS ON CONSTRUCTION SF-1900 & FABRICATION SF-03-DR-C-1901.		TYPE D: DES TYPE C: DES TYPE B: DES TYPE A: DES	Y SERVICES INVESTI SK STUDY SK STUDY AND SITE F SK STUDY WITH SITE SK STUDY WITH SITE AL HOLES	RECONNA RECON AI	ISSANCE	E TY DETE	CTION S	
ITHER SIDE OF EEN FISH PASS		TYPE D	AL HOLES TYPE C	TY	PE B		TYPE	Δ
REPANCIES IN IMENSIONS		_ =			11.20		/	
	APP INFC OR II INVE	ARATUS SHOWN ON RMATION SHOWN I MPLIED. OTHER SU STIGATIONS SHOU	EXISTING PUBLIC OR PRIVA N THIS DRAWING HAS BEEN S BELIEVED TO BE CORRE ICH PLANT OR APPARATUS LD BE UNDERTAKEN ON SI	N OBTAINED CT BUT NO V S MAY ALSO	FROM STA WARRANT BE PRESE	ATUTORY F Y TO THIS I NT BUT NC	RECORDS. S EXPRES OT SHOWN	THE SED
	GRO	UND.						
ANNEL @ L GRADIENT	10)m 8 6	4 2 0 SCAL	5 = 1:200		10		15m
august and any and				_ 1.200				
GRASS	C02.1		RAMP POSITION REVISED GE OF EX CONC APRON	12.07.23	AB	ET	ET	СТ
1000	CO1.1	FOR CO	DNSTRUCTION	07.06.23	AB	DP	ET	СТ
\$10 10	P01.3	MAIN SLOPE	GRADIENT AMENDED	30.03.23	AB	AB	DR	СТ
200	P01.2	MINOR	AMENDMENTS	25.11.22	AB	AB	DR	СТ
4 ⁰⁰¹¹	P01.1		ARY DESIGN STAGE	20.10.22	AB	AB	<u>Ci</u>	
OR GATE -	Rev. Docume	Description nt Control		Date	Author	Designer	Checker	Approver
-0048.	Supplier					Floor, nk House,		
112734 -112734		JBA	Bentle	ey 💧	27 Lee LS T - E i	nk House, King Street, eds, 1 2HL +44 (0)113 4 nfo@jba-ber w.jba-bentle	ntley.co.uk	
1200	Project ⁻	Title						
JBA Bentley 👙		DON RE	GULATOR	S - M	EAD	owo	GAT	E
f work detailed on this		11 116		_ 111				_
flooding to successful to	Drawing							
flooding to properties if		ME	ADOWGA		SH F	PASS		
n. To be lifted using the		GE	NERAL AR	RAN	GEN	1ENT	-	
				•				
road traffic accidents.			Env Age	/1ro	nm	ent	-	
f found contact Ecologist. ecies. Follow Invasive		ight reserved	Age					
ausing river pollution.	Parent N NOT F	Nodel						
weather forecast for rain	Security OFFIC	Classification		Scale 1:200 @ /	A1			
gate operates while	Author		Designer	Checker		Appr		
to prevent gate moving. crushing site team	ADAN Suitabili	I BRANSTON	ADAM BRANSTON	DAN RAN	NSOM	CHF		RNTON evision
rks, risk of		ISHED BUILD &	COMMISSION			A4	- II	evision :01
INS, HSK UI		ion Container 790514-JBAB-SF	-03-DR-C-1700				A1	Sheet Size
	II ····· • • • •							