


- 1. FOR DRAINAGE SCHEDULES SEE DRAWING 82598-DRAIN-EX-103.
- 2. FOR DRAINAGE STANDARD DETAILS SEE DRAWING 82598-DRAIN-EX-104, 82598-DRAIN-EX-105 AND

82598-DRAIN-EX-106

- 3. SURFACE WATER DRAINAGE IS BASED ON AN EQUIVALENT SYPHON WITH AN EQUAL MAXIMUM FLOW RATE.
- 4. FINISHED LEVELS ARE AS PAPA DRAWINGS 82598-ARCH-EX-100 & 101
- 5. PIPES UPTO AND INCLUDING 300mm ARE VITRIFIED CLAY. PIPES WITH A DIAMETER GREATER THAN 300mm ARE CONCRETE.

THIS DRAWING HAS BEEN UPDATED TO
'AS-BUILT' STATUS FROM 'CONSTRUCTION
STATUS' AND HAS INCLUDED ANY INFORMATION
WHICH HAS BEEN PROVIDED BY THE
CONTRACTOR TO SUIT MINOR VARIATIONS ON
DESIGN CHANGES DURING CONSTRUCTION. THIS
HAS BEEN DONE TO THE BEST OF OUR
KNOWLEDGE AND MAY NOT REFLECT FULLY
ANY CHANGES OR VARIATIONS WHICH HAVE
NOT BEEN NOTIFIED TO THE ENGINEER BY THE
CONTRACTOR.

AS BUILT

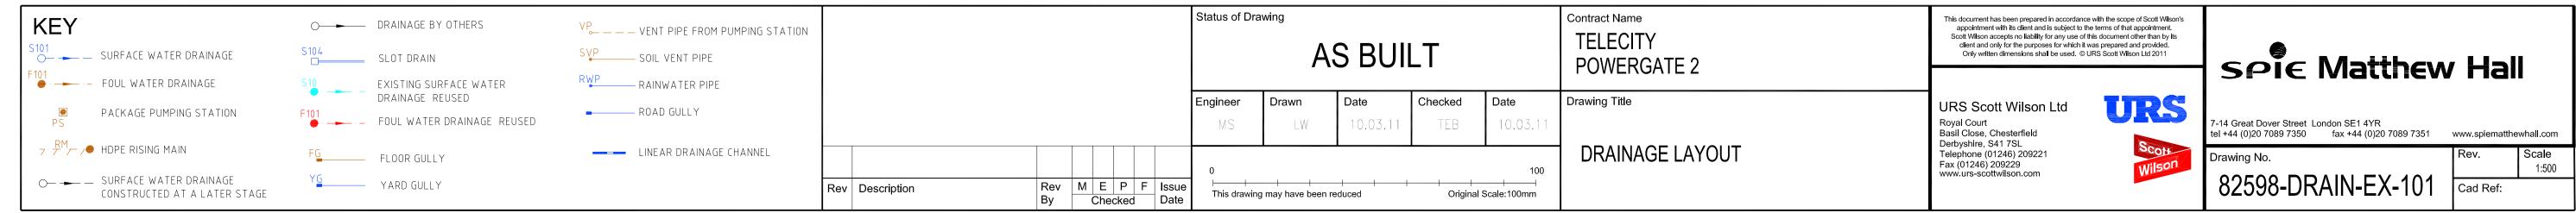

A1 594 X 841