




93-95 Greenford Rd
Harrow
Middlesex
HA1 3QF
Tel: 020 8426 4944
Fax: 020 8426 4966
Website: www.jcoffey.co.uk

Client
mace

- Notes
- PROPOSED SURFACE WATER DRAINAGE (ROADS)
 - PROPOSED SURFACE WATER DRAINAGE (ROOFS)
 - PROPOSED FOUL WATER DRAINAGE
 - PROPOSED CHANNEL DRAIN
 - PROPOSED ROAD GULLY
 - EXISTING SURFACE WATER DRAINAGE
 - EXISTING FOUL WATER DRAINAGE
 - EXISTING DRAINAGE TO BE ABANDONED/DIVERTED
 - PROPOSED PERFORATED DRAINAGE
 - PROPOSED SPRINKLER DRAINAGE

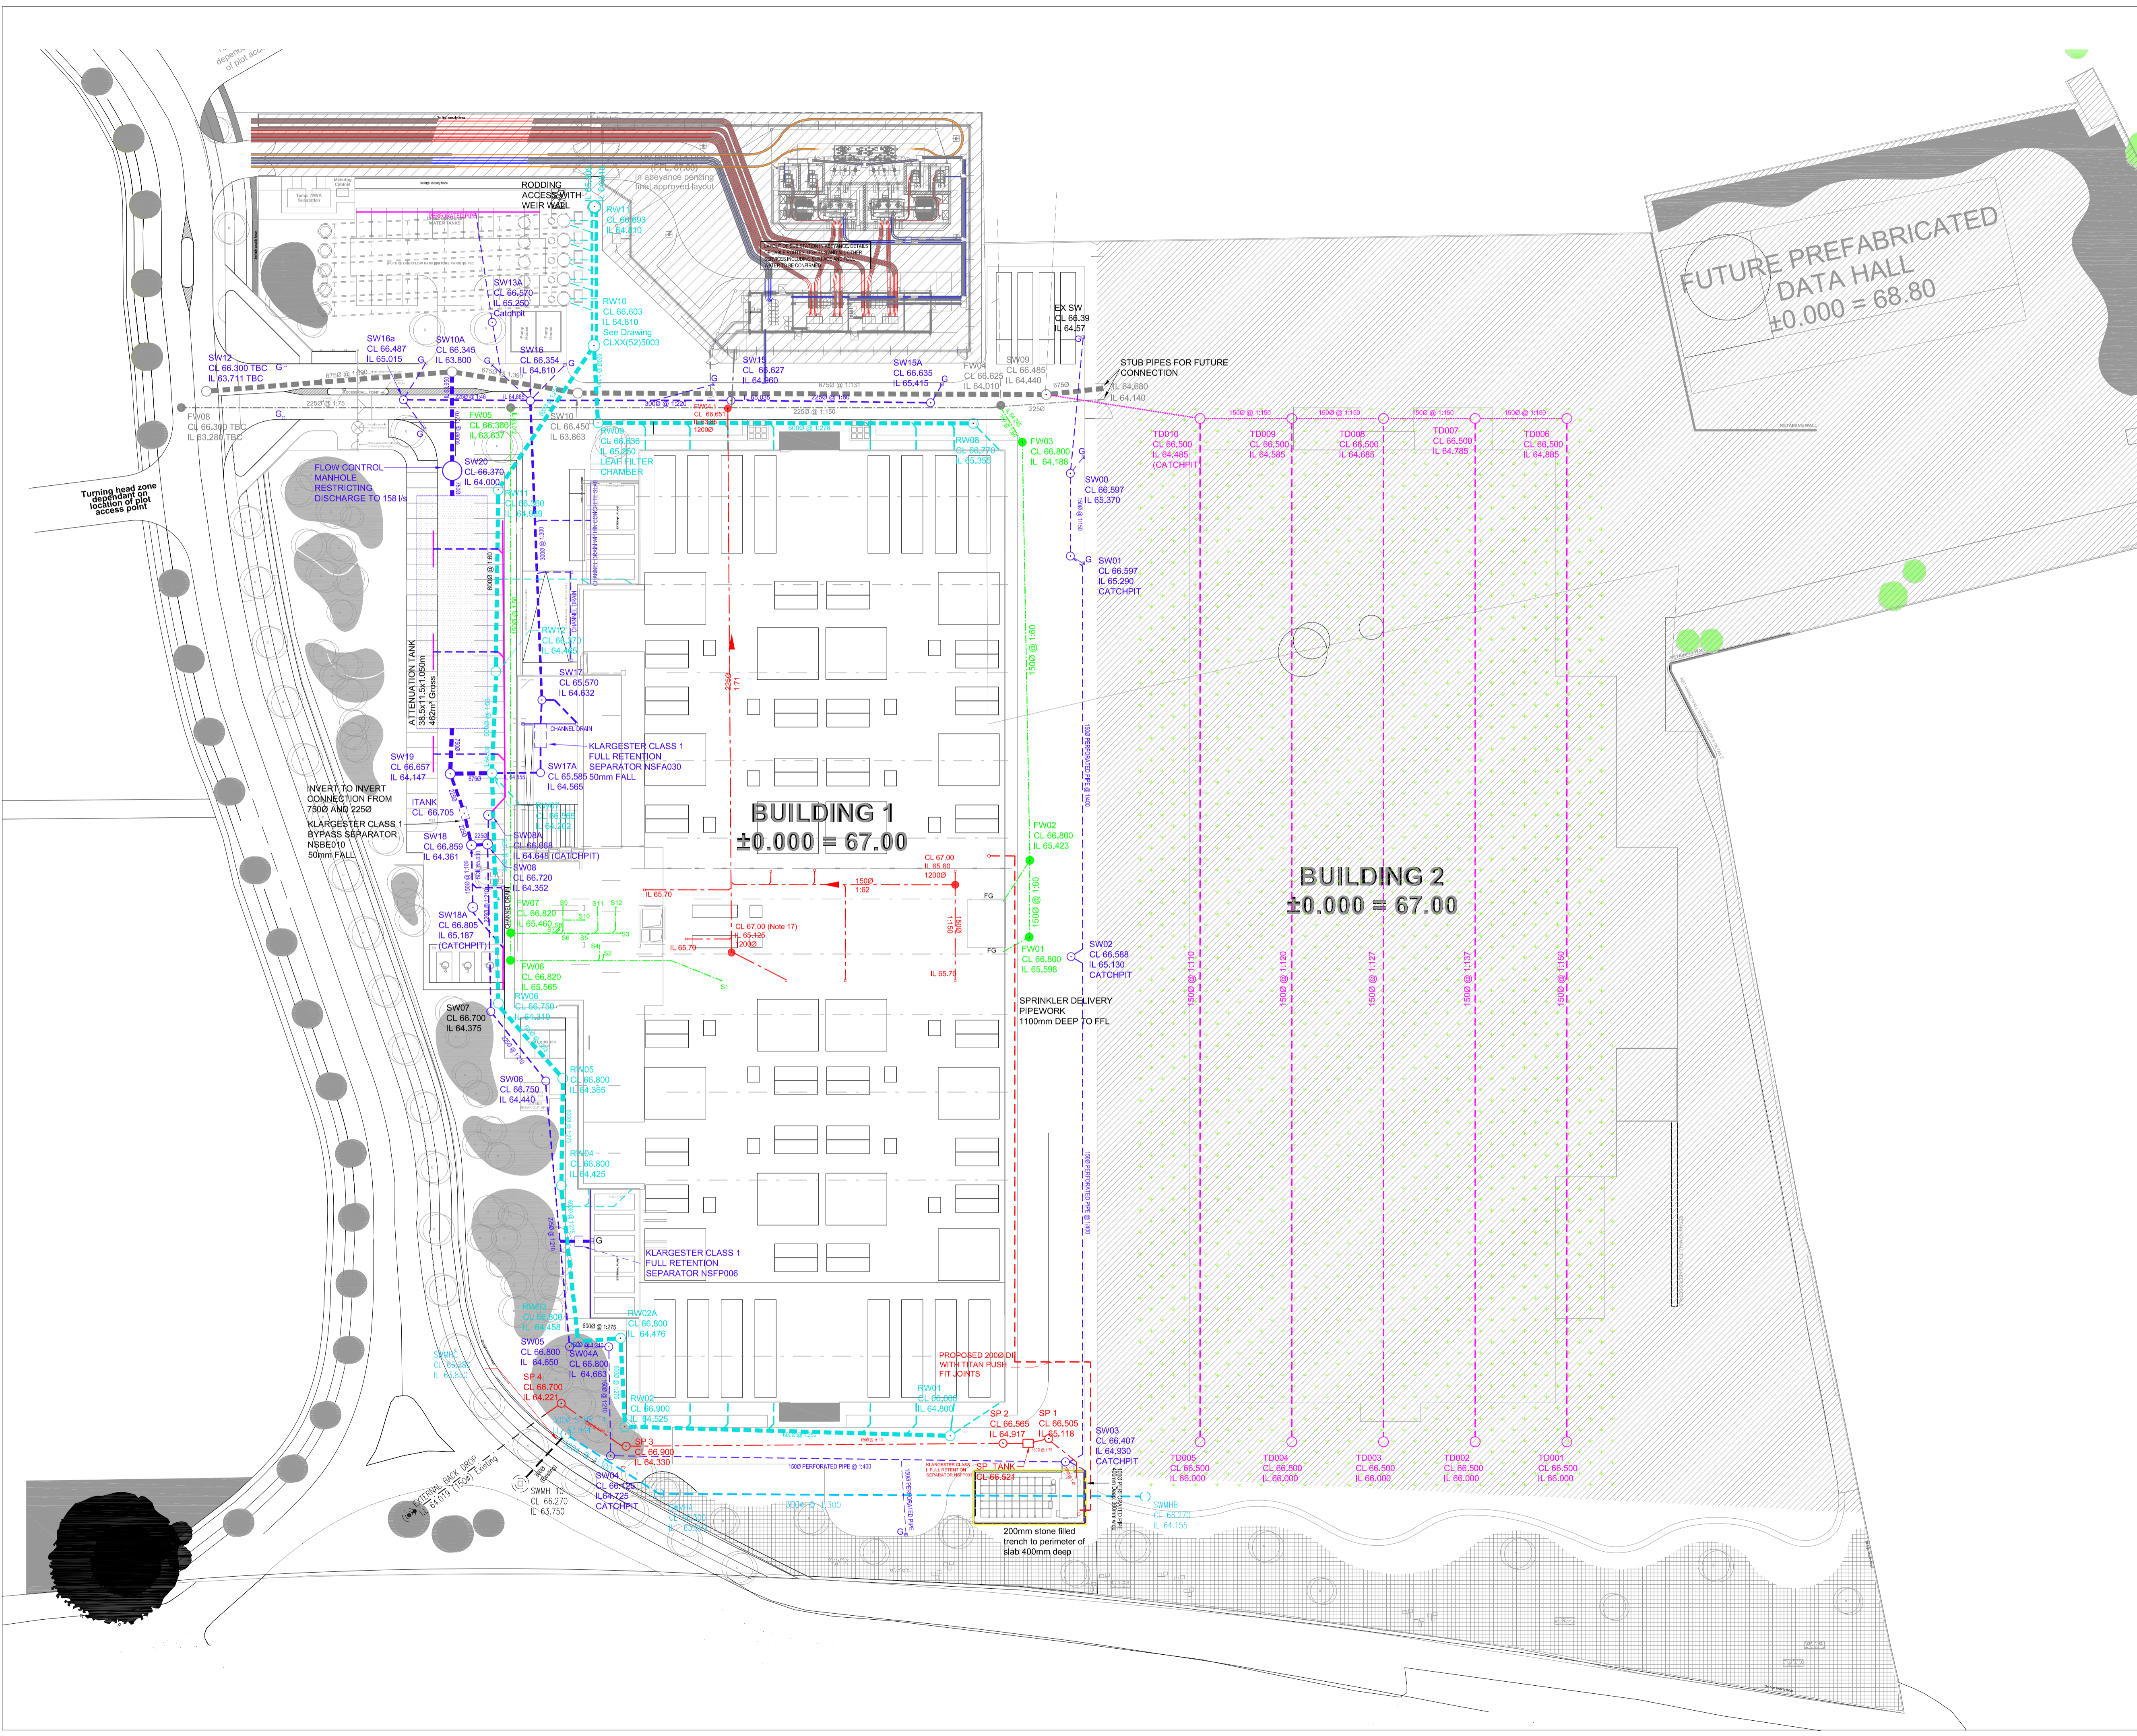

Project
DIGITAL PROJECT MERLIN

Based on:

Architects Drg No.		Rev	
Structural Drg No.	CLXX(90)1001	Rev	Q
Survey Drg No.		Rev	
Other Drg No.		Rev	
Other Drg No.		Rev	

REV	DATE	DESCRIPTION	BY	CHK
R1	12/03/15	ISSUED AS RECORD DRAWING	DM	KK

Drawing No.	2300-DR-00-5001	Drawing Status	AS BUILT
Job No.	1905	Scale	NTS
Originator	D.M	Checked	W.Y
Verified	K.K	Issue	R1

Title
J. COFFEY CONSTRUCTION DRAINAGE AS BUILTS