



KEY	
E	UNDERGROUND ELECTRICITY
W	POTABLE WATER
WW	WASHWATER
CS	COMBINED SEWER
DRA	DRAIN
S	SLUDGE
FE	FINAL EFFLUENT
G	GAS MAIN
T	UNDERGROUND TELECOM
TO	OVERHEAD TELECOM
HV	HV DUCT ROUTE
LV	LV DUCT ROUTE
HVOH	HV OVERHEAD CABLE
RS	RAW SLUDGE
RAS	RETURN ACTIVATED SLUDGE
SAS	SURPLUS ACTIVATED SLUDGE
ML	MIXED LIQUORS
TS	THICKENED SLUDGE
A	AIR/ODOUR DUCT
STORM	STORM WATER
?	UNKNOWN SERVICES

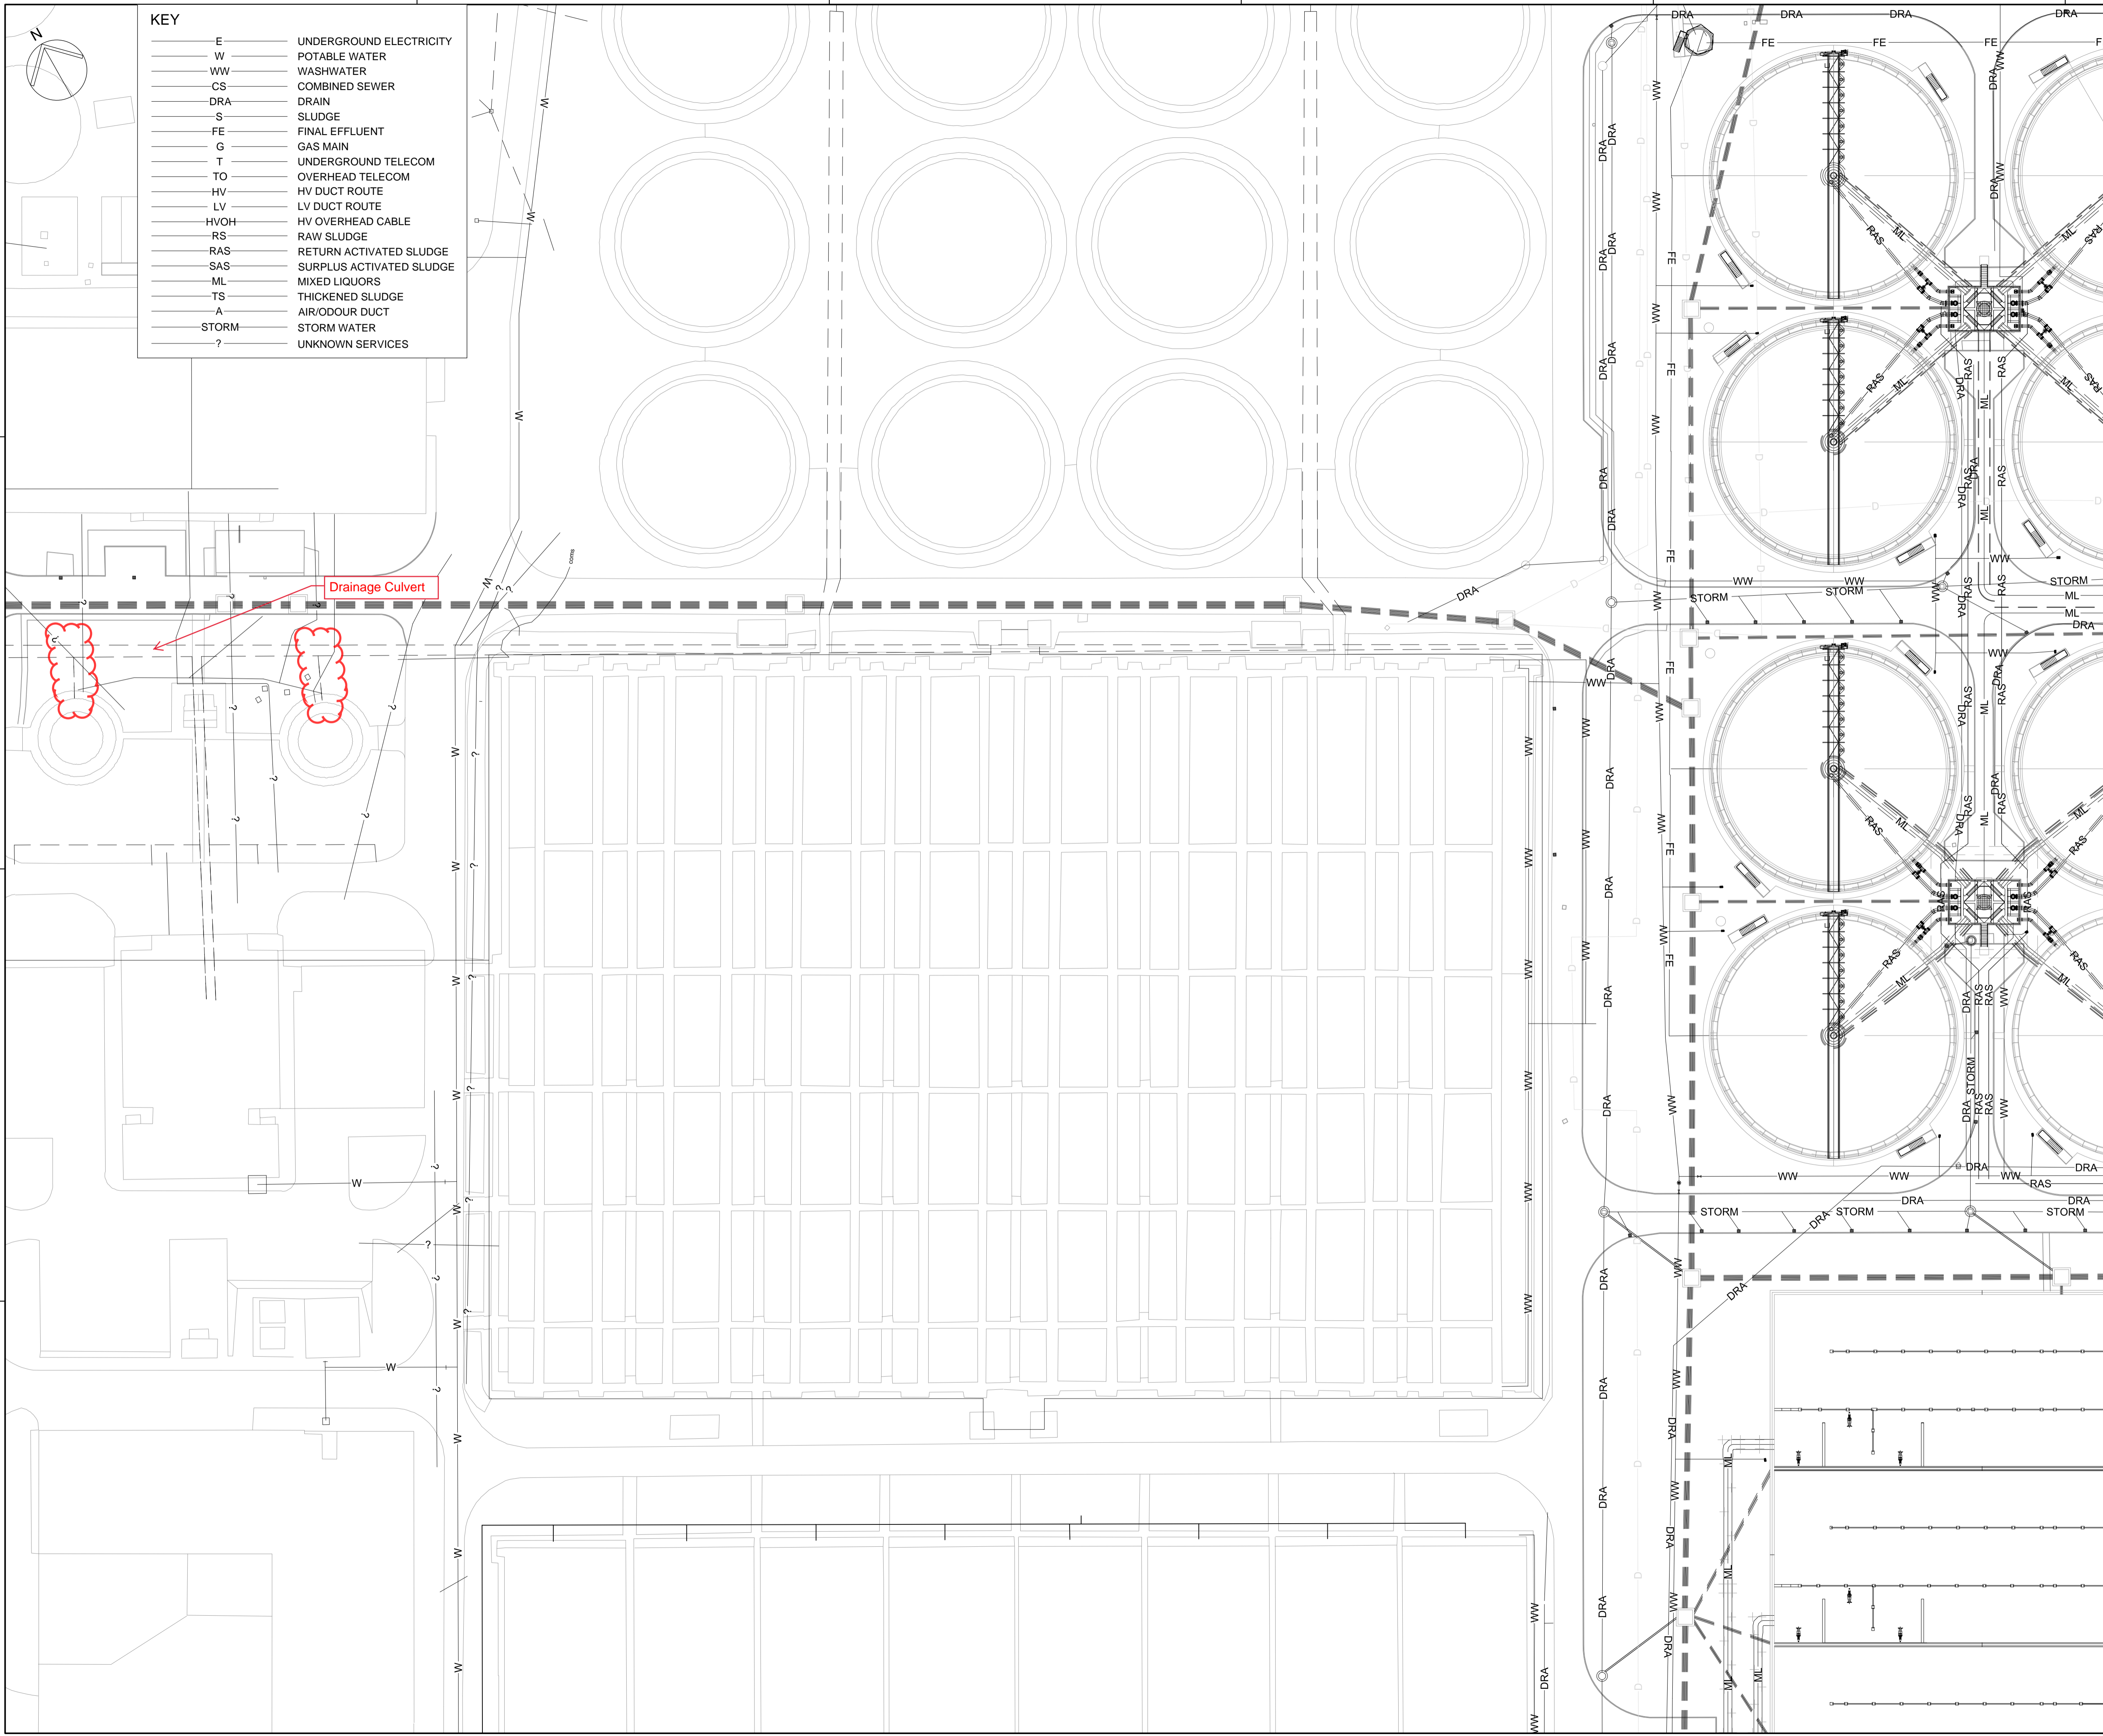

DO NOT SCALE - IF IN DOUBT ASK

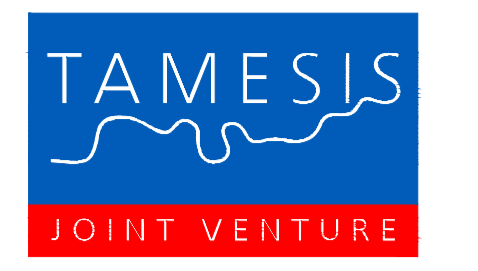

Laing O'Rourke
 Bridge Place,
 Admirals Park,
 Dartford, Kent,
 DA2 6SN
 Tel: 01322 296200
 Fax: 01322 296262


Imtech
 ImtechProcess
 Imtech House
 5 Newlands Court
 Attercliffe Road
 Burnford
 Staffordshire
 WS7 3EP
 Tel: 01543 496600
 Fax: 01543 496601




HYDER CONSULTING (UK) Limited
 HCL House
 51 Mellons Business Park
 Cardiff
 CF3 8EY
 Tel: 02920 925800
 Fax: 02920 925222

REFERENCE DRAWINGS

NOTES

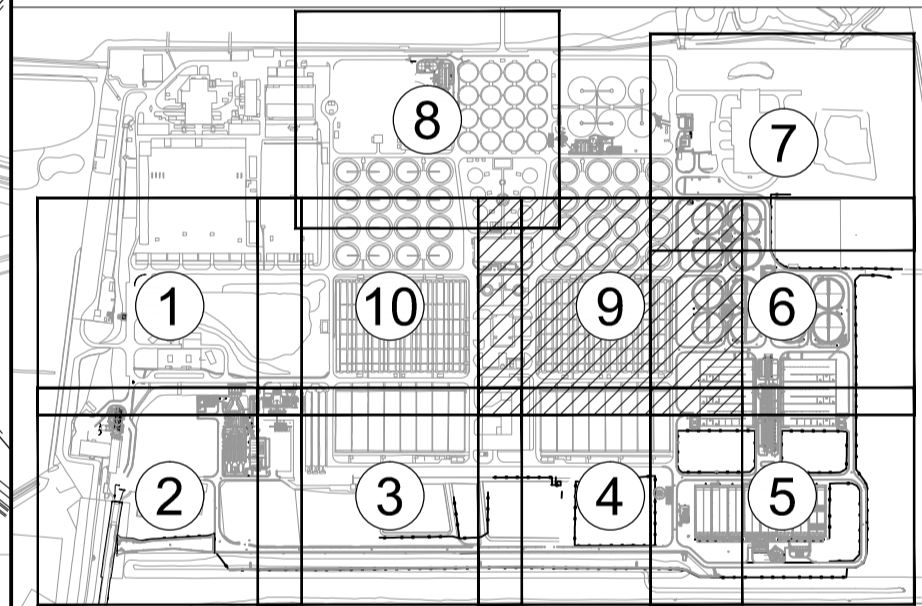

KEY PLAN
1 : 10000

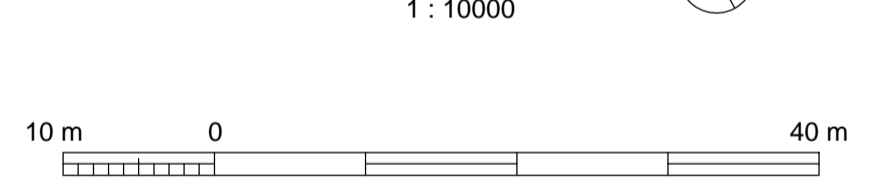

Iss	Description	DO	RKM	TC	05-06-15
X	AS CONSTRUCTED				

Thames Water Utilities
CAPITAL DELIVERY
 Rose Kiln Court
 Rose Kiln Lane, Reading, RG2 0BY

Location Code: CROSS1ZZ	OS Reference: TQ 482 807	Security Reference: UBR	Drawn By: KGS
Project Group: CAPITAL DELIVERY		Sub Process:	
Location / Town: CROSSNESS - ABBEY WOOD			
Site Name: CROSSNESS STW			
Project Name: TTQI - CROSSNESS STW			
Contract Name: MAIN CONTRACT			
Drawing Title: SITE SERVICES LAYOUT - SHEET-9			

Drawing No: 1X8F-A1-22113	Scale: 1:500	Sheet Size: A1	Rev: X
------------------------------	-----------------	-------------------	-----------