




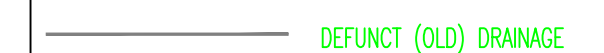


General Notes


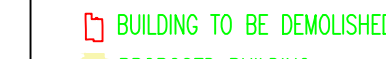





THE INFORMATION ON THIS AS BUILT DRAWING IS SOURCED FROM A COMBINATION OF A NUMBER OF DRAWINGS FROM VARIOUS PROJECTS. WHILST WE HAVE SOURCED THE MOST UP TO DATE INFORMATION, NO ATTEMPT HAS BEEN MADE TO CONFIRM THE INDICATED ASSET LOCATION OR RECTIFY DISCREPANCIES


LEGEND

-  CARRIER DRAIN
-  COLLECTOR DRAIN
-  PROPOSED CARRIER DRAIN
-  PROPOSED COLLECTOR DRAIN
-  PROPOSED ATTENUATION TANK
-  DEFUNCT (OLD) DRAINAGE

TERMINOLOGY KEY

- PD - Pit Depth
- WL - Water Level
- UTL - Unable to Lift
- CL - Cover Level
- IL - Invert Level
- MH - Manhole
- d - Depth
- CP - CATCHPIT

-  INTERCEPTOR
-  BUILDING TO BE DEMOLISHED
-  PROPOSED BUILDING
-  EXISTING BUILDING
-  ACCESS COVER
-  PROPOSED DETENTION BASIN
-  EXISTING DETENTION BASIN

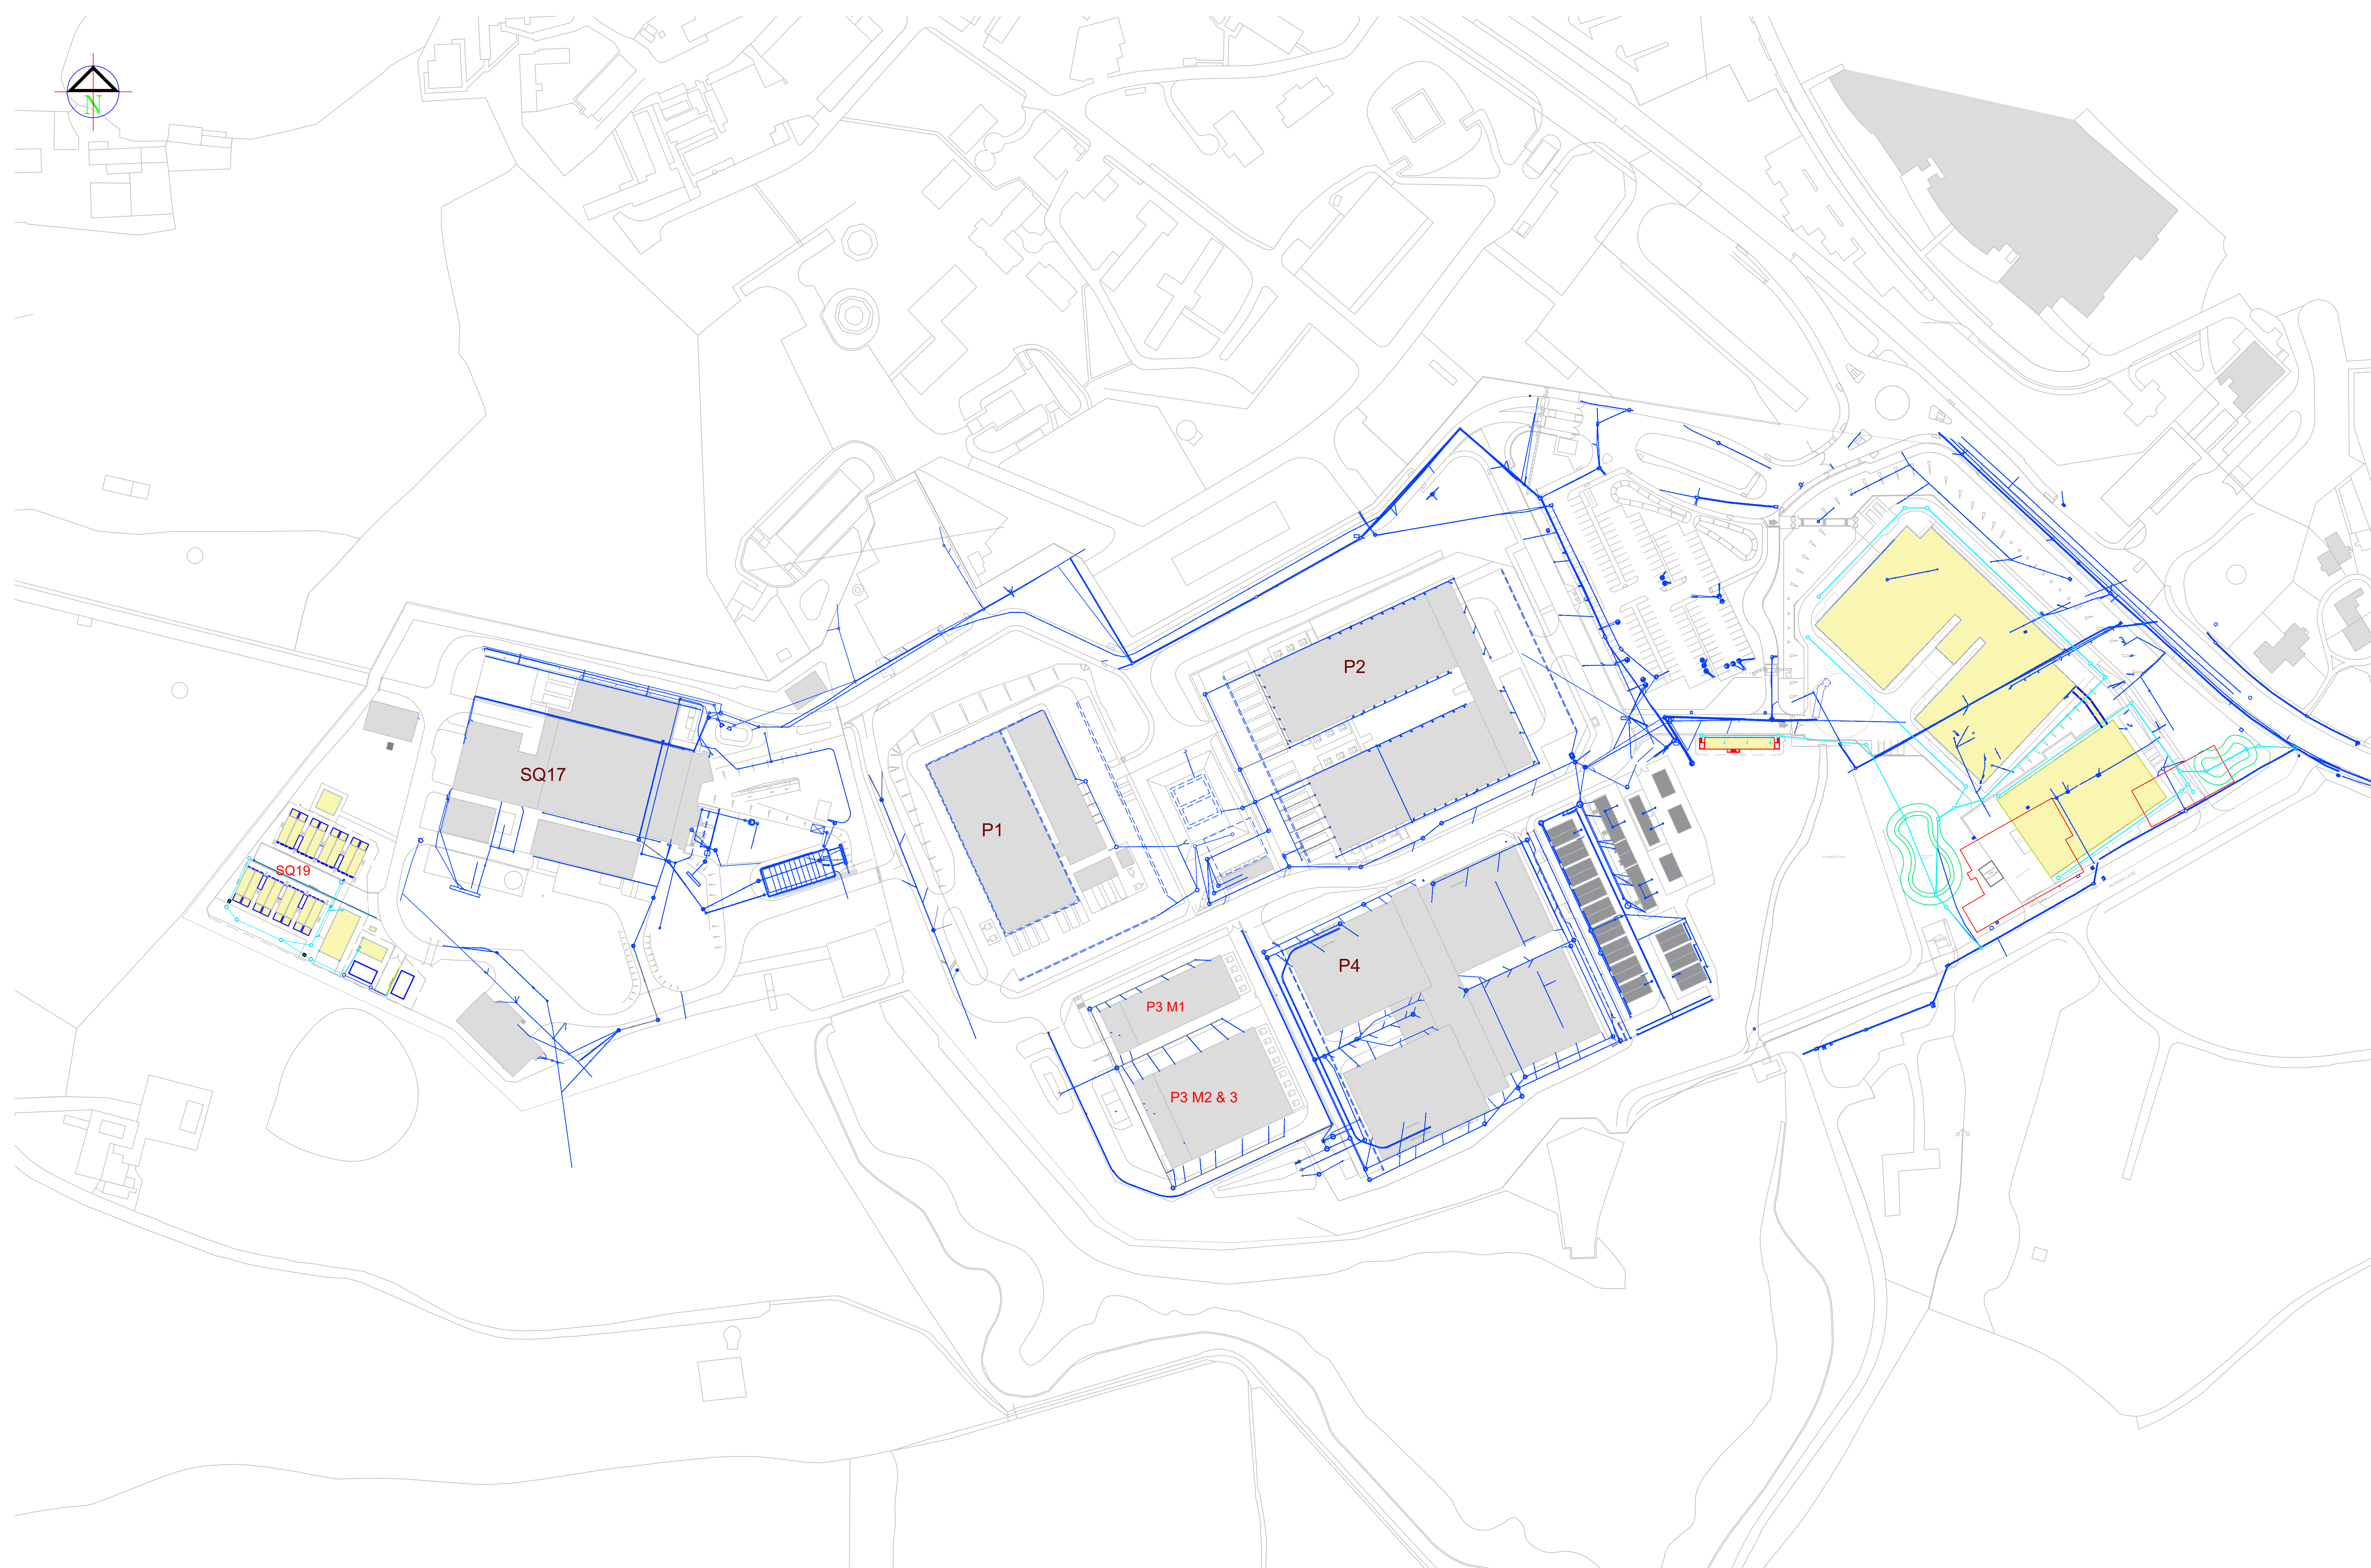

Rev	Date	Description	By
P04	14.04.23	AMENDMENTS MADE	CJ
P03	17.10.22	AMENDMENTS MADE	EM
P02	15.09.22	AMENDMENTS MADE	EM
P01	11.08.22	FIRST ISSUE	LB

Project		SPRING PARK
Title		MASTERPLAN SERVICES OVERALL LAYOUT SURFACE WATER
Client		ARK SPRING PARK LTD



Waterman
Mechanics House, Wapping Road, Essex SS14 6BW
1817 837 836 / 1 800 444 511
w@watermangroup.com / www.watermangroup.com

INFORMATION			
Designed by	LB	Checked by	PM
Drawn by	LB	Date	JULY22
Project No	19339	Scale	1:500
Project Name	WIE	Zone	ZZ
Project No	90	Issue	0002
Project No	P04		

