


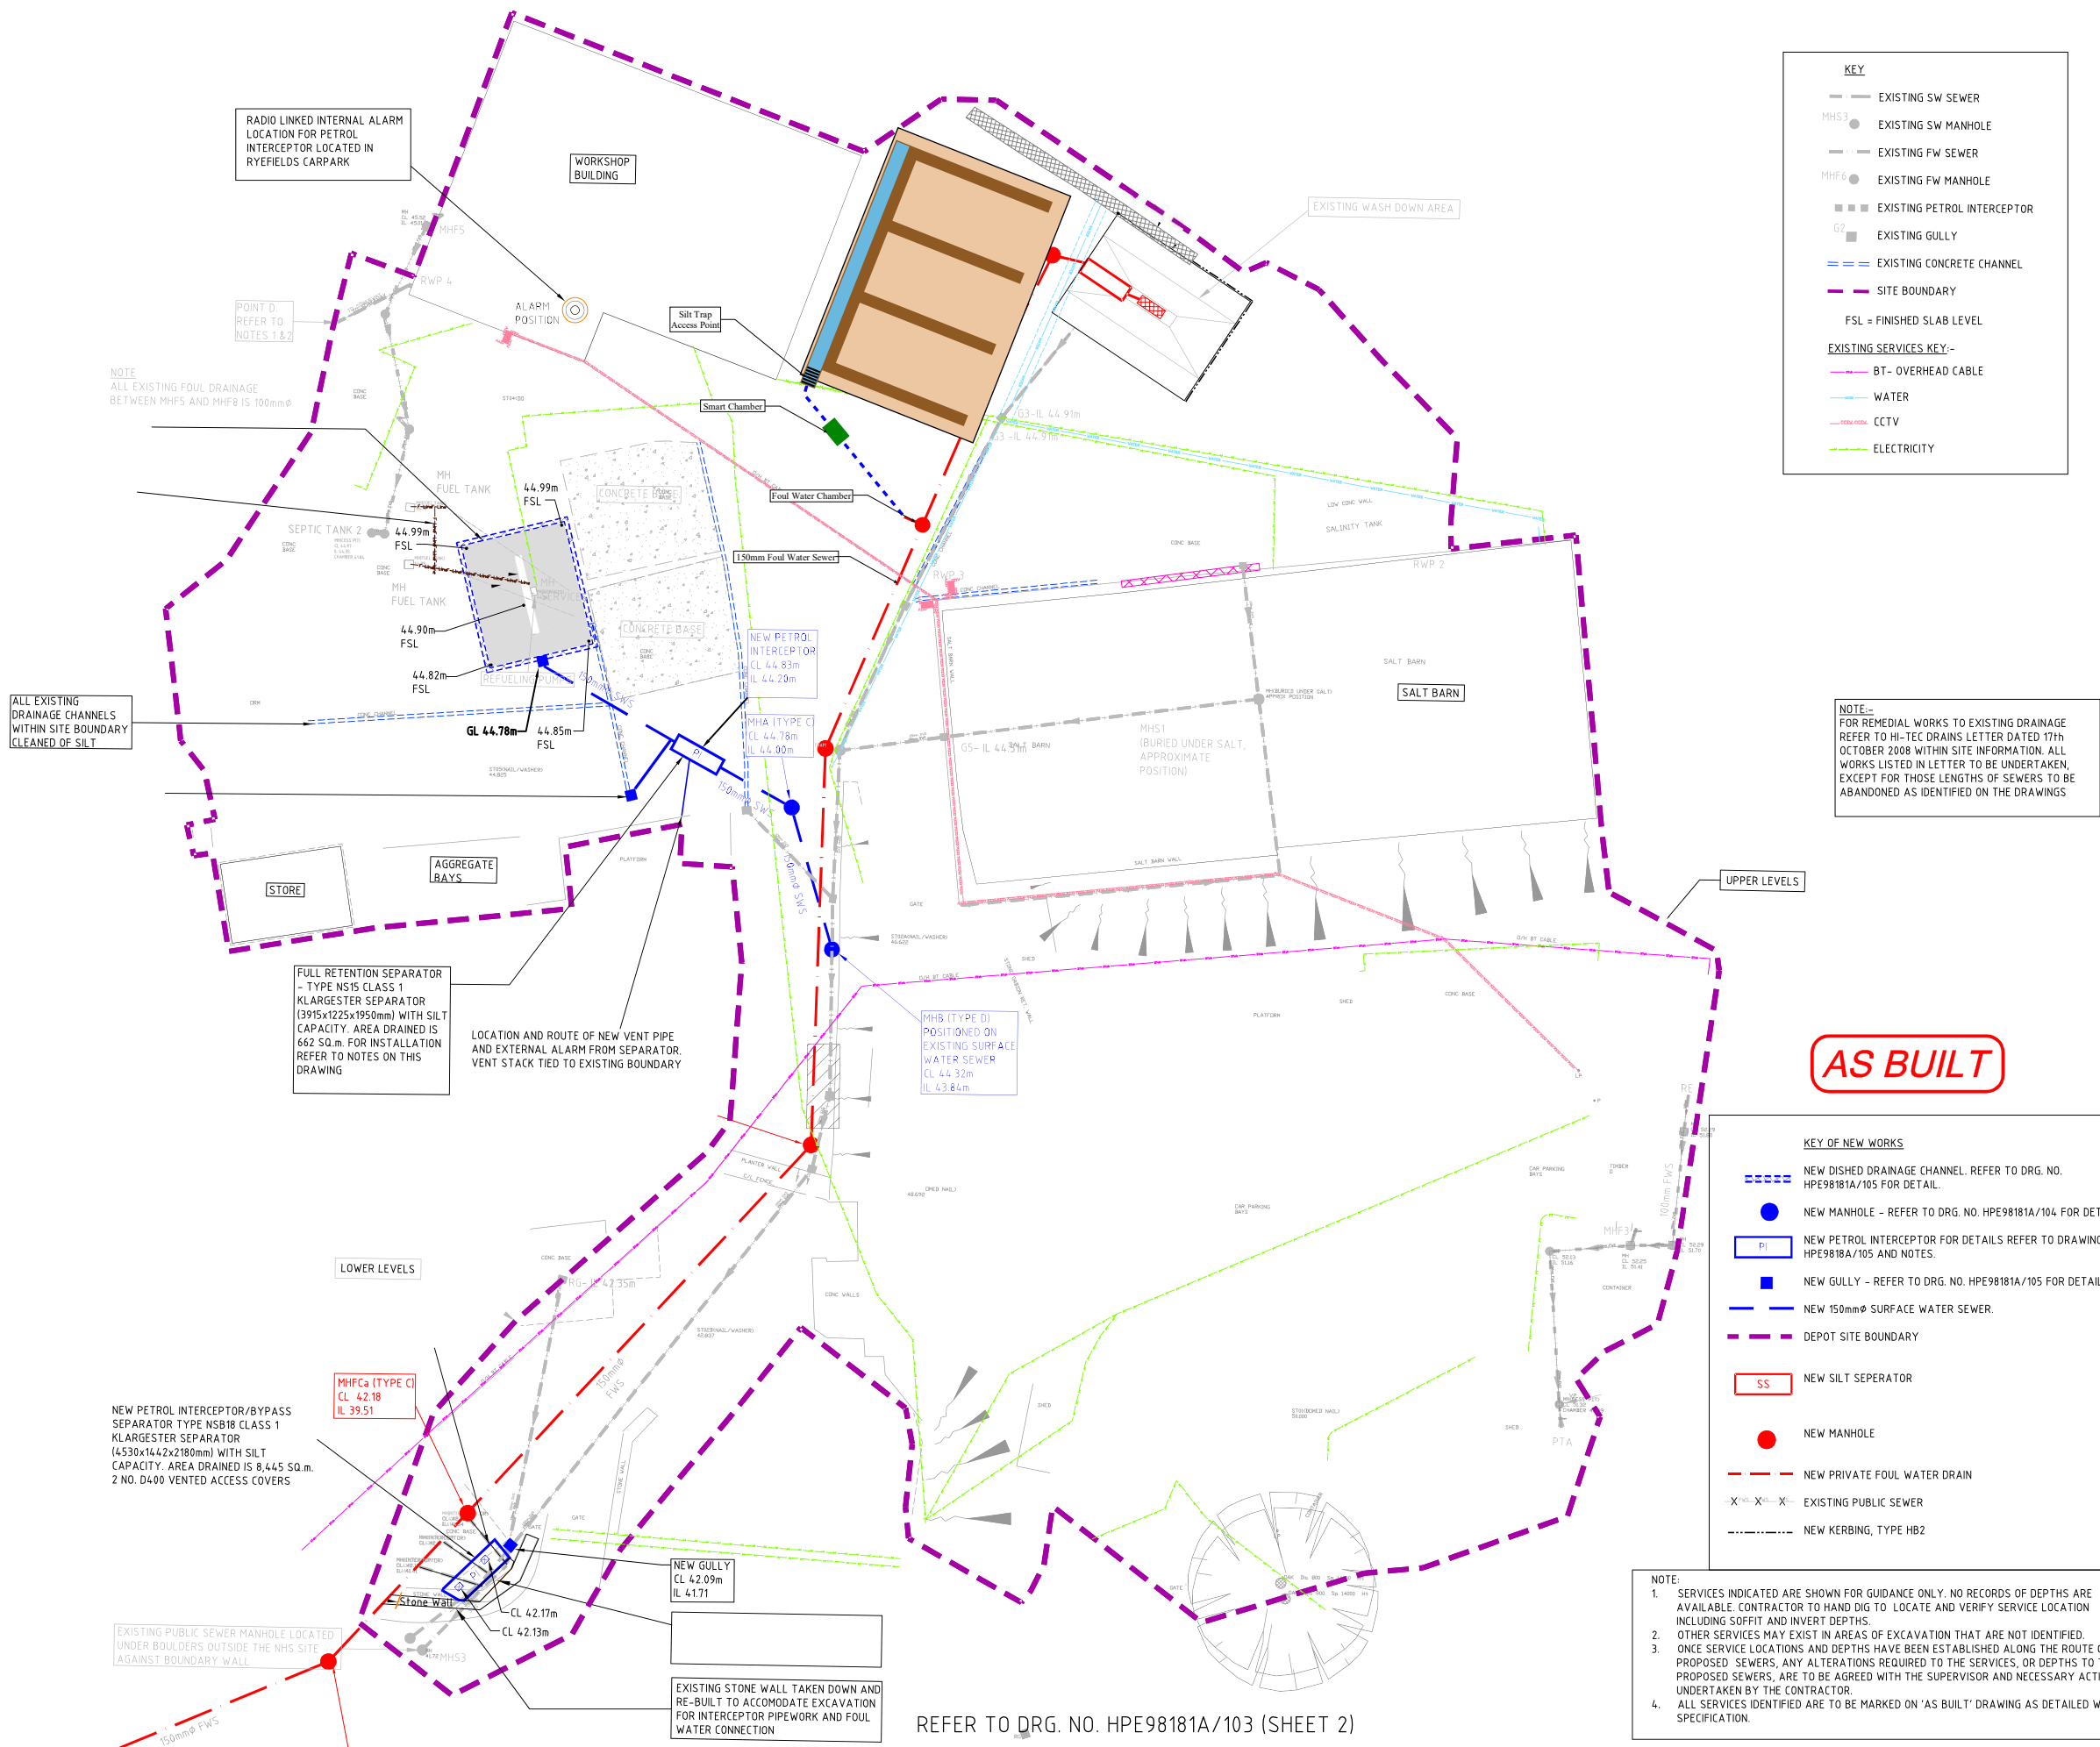

KEY

- EXISTING SW SEWER
- MHS3 ● EXISTING SW MANHOLE
- EXISTING FW SEWER
- MHF6 ● EXISTING FW MANHOLE
- EXISTING PETROL INTERCEPTOR
- G2 ■ EXISTING GULLY
- == EXISTING CONCRETE CHANNEL
- - - SITE BOUNDARY
- FSL = FINISHED SLAB LEVEL

EXISTING SERVICES KEY:-

- BT - OVERHEAD CABLE
- WATER
- CCTV
- ELECTRICITY

NOTE:-
FOR REMEDIAL WORKS TO EXISTING DRAINAGE
REFER TO HI-TEC DRAINS LETTER DATED 17TH
OCTOBER 2008 WITHIN SITE INFORMATION. ALL
WORKS LISTED IN LETTER TO BE UNDERTAKEN,
EXCEPT FOR THOSE LENGTHS OF SEWERS TO BE
ABANDONED AS IDENTIFIED ON THE DRAWINGS

AS BUILT

KEY OF NEW WORKS

- ==== NEW DISHED DRAINAGE CHANNEL. REFER TO DRG. NO. HPE98181A/105 FOR DETAIL.
- NEW MANHOLE - REFER TO DRG. NO. HPE98181A/104 FOR DETAILS.
- PI NEW PETROL INTERCEPTOR FOR DETAILS REFER TO DRAWING No HPE98181A/105 AND NOTES.
- NEW GULLY - REFER TO DRG. NO. HPE98181A/105 FOR DETAIL.
- == NEW 150mmØ SURFACE WATER SEWER.
- - - DEPOT SITE BOUNDARY
- SS NEW SILT SEPARATOR
- NEW MANHOLE
- - - NEW PRIVATE FOUL WATER DRAIN
- - - EXISTING PUBLIC SEWER
- - - NEW KERBING, TYPE HB2

NOTE:
1. SERVICES INDICATED ARE SHOWN FOR GUIDANCE ONLY. NO RECORDS OF DEPTHS ARE AVAILABLE. CONTRACTOR TO HAND DIG TO LOCATE AND VERIFY SERVICE LOCATION INCLUDING SOFFIT AND INVERT DEPTHS.
2. OTHER SERVICES MAY EXIST IN AREAS OF EXCAVATION THAT ARE NOT IDENTIFIED.
3. ONCE SERVICE LOCATIONS AND DEPTHS HAVE BEEN ESTABLISHED ALONG THE ROUTE OF THE PROPOSED SEWERS, ANY ALTERATIONS REQUIRED TO THE SERVICES, OR DEPTHS TO THE PROPOSED SEWERS, ARE TO BE AGREED WITH THE SUPERVISOR AND NECESSARY ACTIONS UNDERTAKEN BY THE CONTRACTOR.
4. ALL SERVICES IDENTIFIED ARE TO BE MARKED ON 'AS BUILT' DRAWING AS DETAILED WITHIN SPECIFICATION.

REFER TO DRG. NO. HPE98181A/103 (SHEET 2)

REVISIONS					
no.	date	details	by	chkd	appd
A	07.05.09	TENDER ISSUE	RLD	DR	DR
B	20.07.09	NOTES AND KEY REVISED	RLD	BN	BN
T1	24.11.09	TENDER ISSUE	BH	BN	JM
C1	24.02.10	CONSTRUCTION ISSUE	GR	ME	JM
C2	03.03.10	LAYER MISALIGNMENT CORRECTED	ME	DR	DR
C3	30.03.10	MHFX MOVED, STUB ADDED	ME	DR	DR
AB1	24.06.10	AS BUILT ISSUE	TCB	SG	MB

- NOTES**
- DO NOT SCALE FROM THIS DRAWING USE FIGURED DIMENSIONS ONLY.
 - ALL DIMENSIONS AND LEVELS ARE IN METRES UNLESS NOTED OTHERWISE.
 - REFER TO DRAWING No's. HPE98181A / 104 & 105 FOR DETAILS OF MANHOLES, CONCRETE SURROUND TO SEWERS AND PIPE BEDDING.
 - FOR STANDARD DETAILS REFER TO DRAWING No. HPE98181A/104 & 105.
 - ALL DRAINAGE CONSTRUCTED FROM DOWNSTREAM END.
 - ALL DRAINAGE TO HAVE CONCRETE BED AND SURROUND UNLESS OTHERWISE STATED. FOR DETAILS REFER TO DRAWING No. HPE98181A/104.
 - ALL LEVELS IN METRES AND DIMENSIONS IN MILLIMETRES.
 - REFER TO DRAWING No. HPE98181A/100 FOR INDICATIVE LOCATION OF UNDERGROUND SERVICES.

designed RLD	produced TS	checked ME	approved DR
scale(s) 1:250 @ A1	date 11/02/10		

ACAD Ref
100.dwg



**Director of Environment,
Economy and Culture**

PARSONS BRINCKERHOFF
1988
Parsons Brinckerhoff
The Forum, Barnfield Road, Exeter, Devon, EX1 1QR
Tel: 44-(0)1392 229700 Fax: 44-(0)1392 229701

JOB
RYDON QUARRY
HIGHWAYS DEPOT
NEWTON ABBOT

DRAWING TITLE
PROPOSED WORKS
(SHEET 1 OF 2)
CONNECTION TO PUBLIC
FOUL SEWER

drawing number
HPE98181A/102 AB1