



EA PER

KEY



PERMIT BOUNDARY FOR FINE ENVIRONMENTAL SERVICES



PERMIT BOUNDARY FOR VICTREX

SITE BOUNDARY

C	31.03.26	SITE LAYOUT	CW	AL				
B	10.04.25	SITE LAYOUT	CW					
A	08.02.23	SITE LAYOUT	CW					
REV	DATE	DESCRIPTION OF REVISION	BY	PDW	PROC	MECH	INST	PROD

ISSUED FOR AS BUILT

CHECKED BY (Process Engineer)

Sig: Date:.....

CHECKED BY (Instrument Engineer)

Sig: Date:.....

APPROVED BY (Process Co-Ordinator.)

Sig: Date:.....

THIS DRAWING REMAINS THE PROPERTY OF
Lianhetechn Seal Sands
IT MUST NOT BE COPIED, LENT OR SHOWN TO THIRD PARTIES
WITHOUT WRITTEN CONSENT OF THE COMPANY AND MUST BE
RETURNED TO THE COMPANY ON DEMAND

REFERENCE DRAWINGS

Lianhetechn
Lianhetechn Seal Sands, Seal Sands,
Middlebrough, Cleveland, TS2 1UB, UK
Tel: +44 (0)1642 548666 Fax: +44 (0)1642 548646

REFERENCE DRAWINGS


DRG No. SL-0-1605 REV. C

TITLE FINE ORGANICS SEAL SANDS LAYOUT
SHOWING FES, VICTREX BOUNDARIES,
AIR EMISSION & CHP EMISSION POINTS

SCALE	1:500	CAD REF: SL01605-C.dwg
PROCESS NAME	N/A	
PLANT AREA	GENERAL SITE	
PROJECT NUMBER		
EQUIPMENT No.		



GREENERGY BIOFUELS TEESIDE

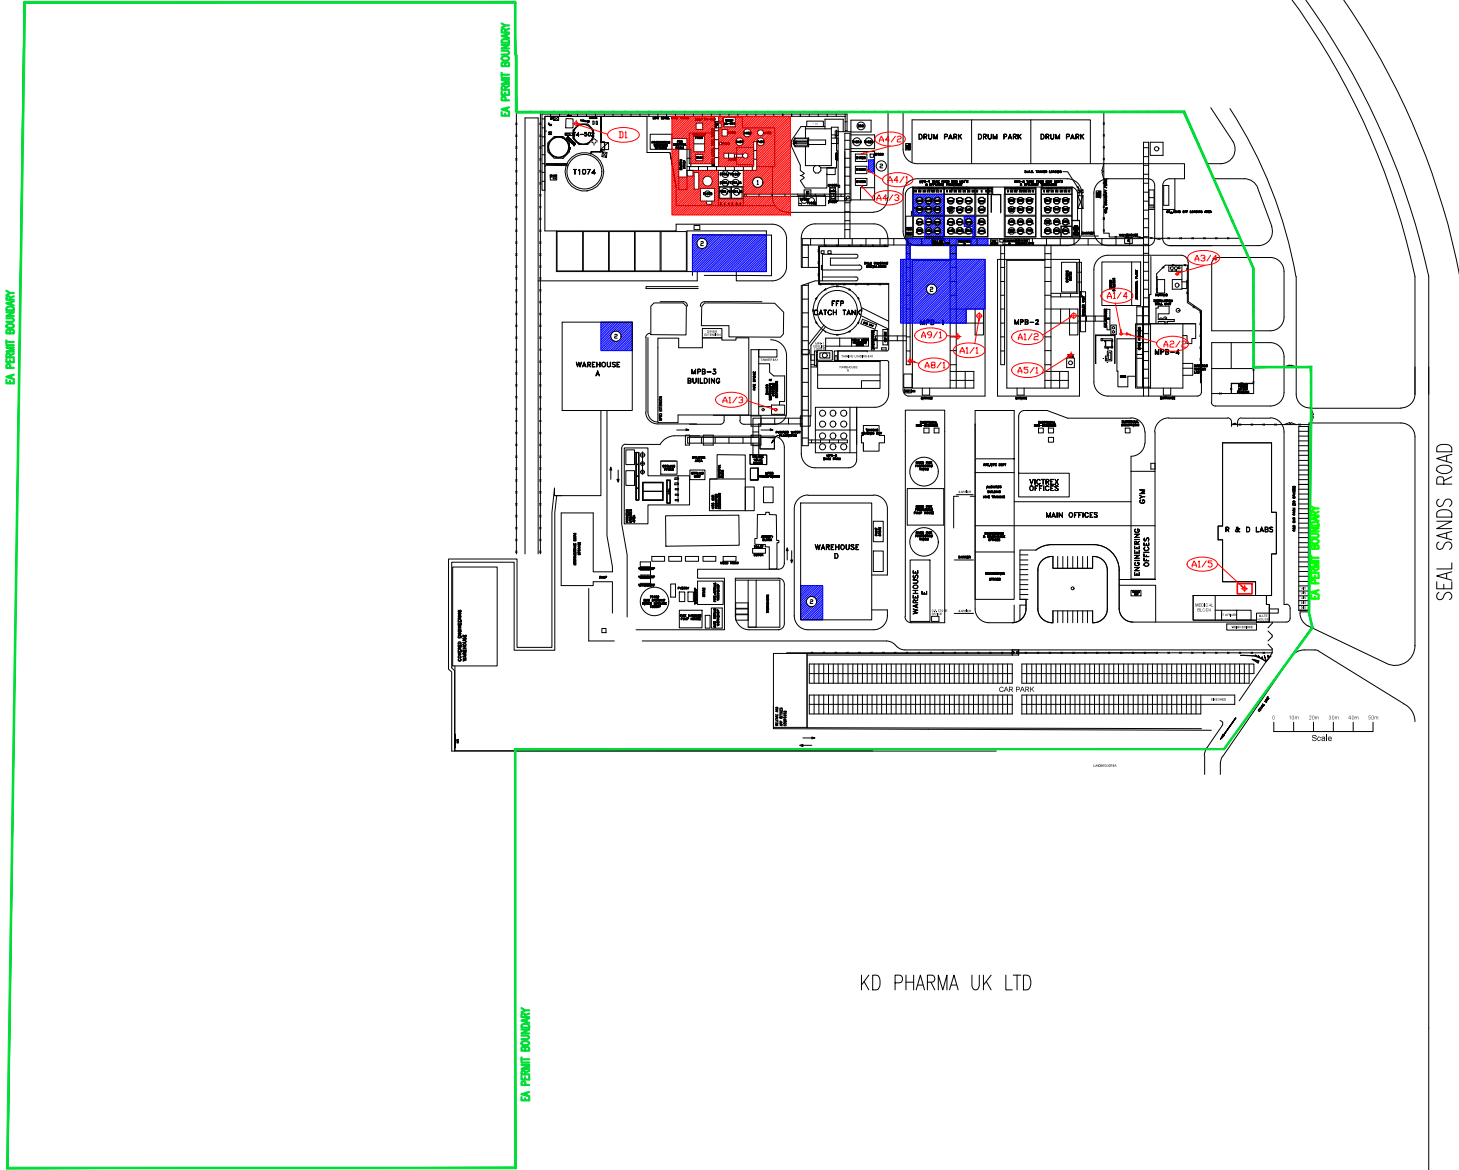

KEY

1

PERMIT BOUNDARY FOR FINE ENVIRONMENTAL SERVICES

2

PERMIT BOUNDARY FOR VICTREX

SITE BOUNDARY

KD PHARMA UK LTD

C	31.03.26	SITE LAYOUT	CW	AL				
B	10.04.25	SITE LAYOUT	CW					
A	08.02.23	SITE LAYOUT	CW					
REV	DATE	DESCRIPTION OF REVISION	BY	PDM	PROC.	MECH.	INST.	PROD.
ISSUED FOR AS BUILT								
CHECKED BY (Process Engineer)								
Sig: Date:.....								
CHECKED BY (Instrument Engineer)								
Sig: Date:.....								
APPROVED BY (Process Co-Ordinator.)								
Sig: Date:.....								

THIS DRAWING REMAINS THE PROPERTY OF
Lianheteck Seal Sands
IT MUST NOT BE COPIED, LENT OR SHOWN TO THIRD PARTIES
WITHOUT WRITTEN CONSENT OF THE COMPANY AND MUST BE
RETURNED TO THE COMPANY ON DEMAND

REFERENCE DRAWINGS	

Lianheteck
Lianheteck Seal Sands, Seal Sands,
Middlebrough, Cleveland, TS2 1UB, UK
Tel: +44 (0)1642 546666 Fax: +44 (0)1642 546046

REFERENCE DRAWINGS	

DRG No.	SL-0-1605A	REV.	C
TITLE LIANHETECH - SEAL SANDS - LAYOUT SHOWING SITE BOUNDARY & SURROUNDING AREAS			

SCALE	1:1000	CAD REF: SL01605-C.dwg
PROCESS NAME	N/A	
PLANT AREA	GENERAL SITE	
PROJECT NUMBER		
EQUIPMENT No.		