



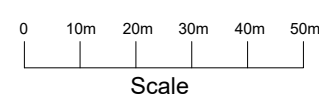

KEY


- 1 PERMIT BOUNDARY FOR FINE ENVIRONMENTAL SERVICES
- 2 PERMIT BOUNDARY FOR VICTREX
- SITE BOUNDARY

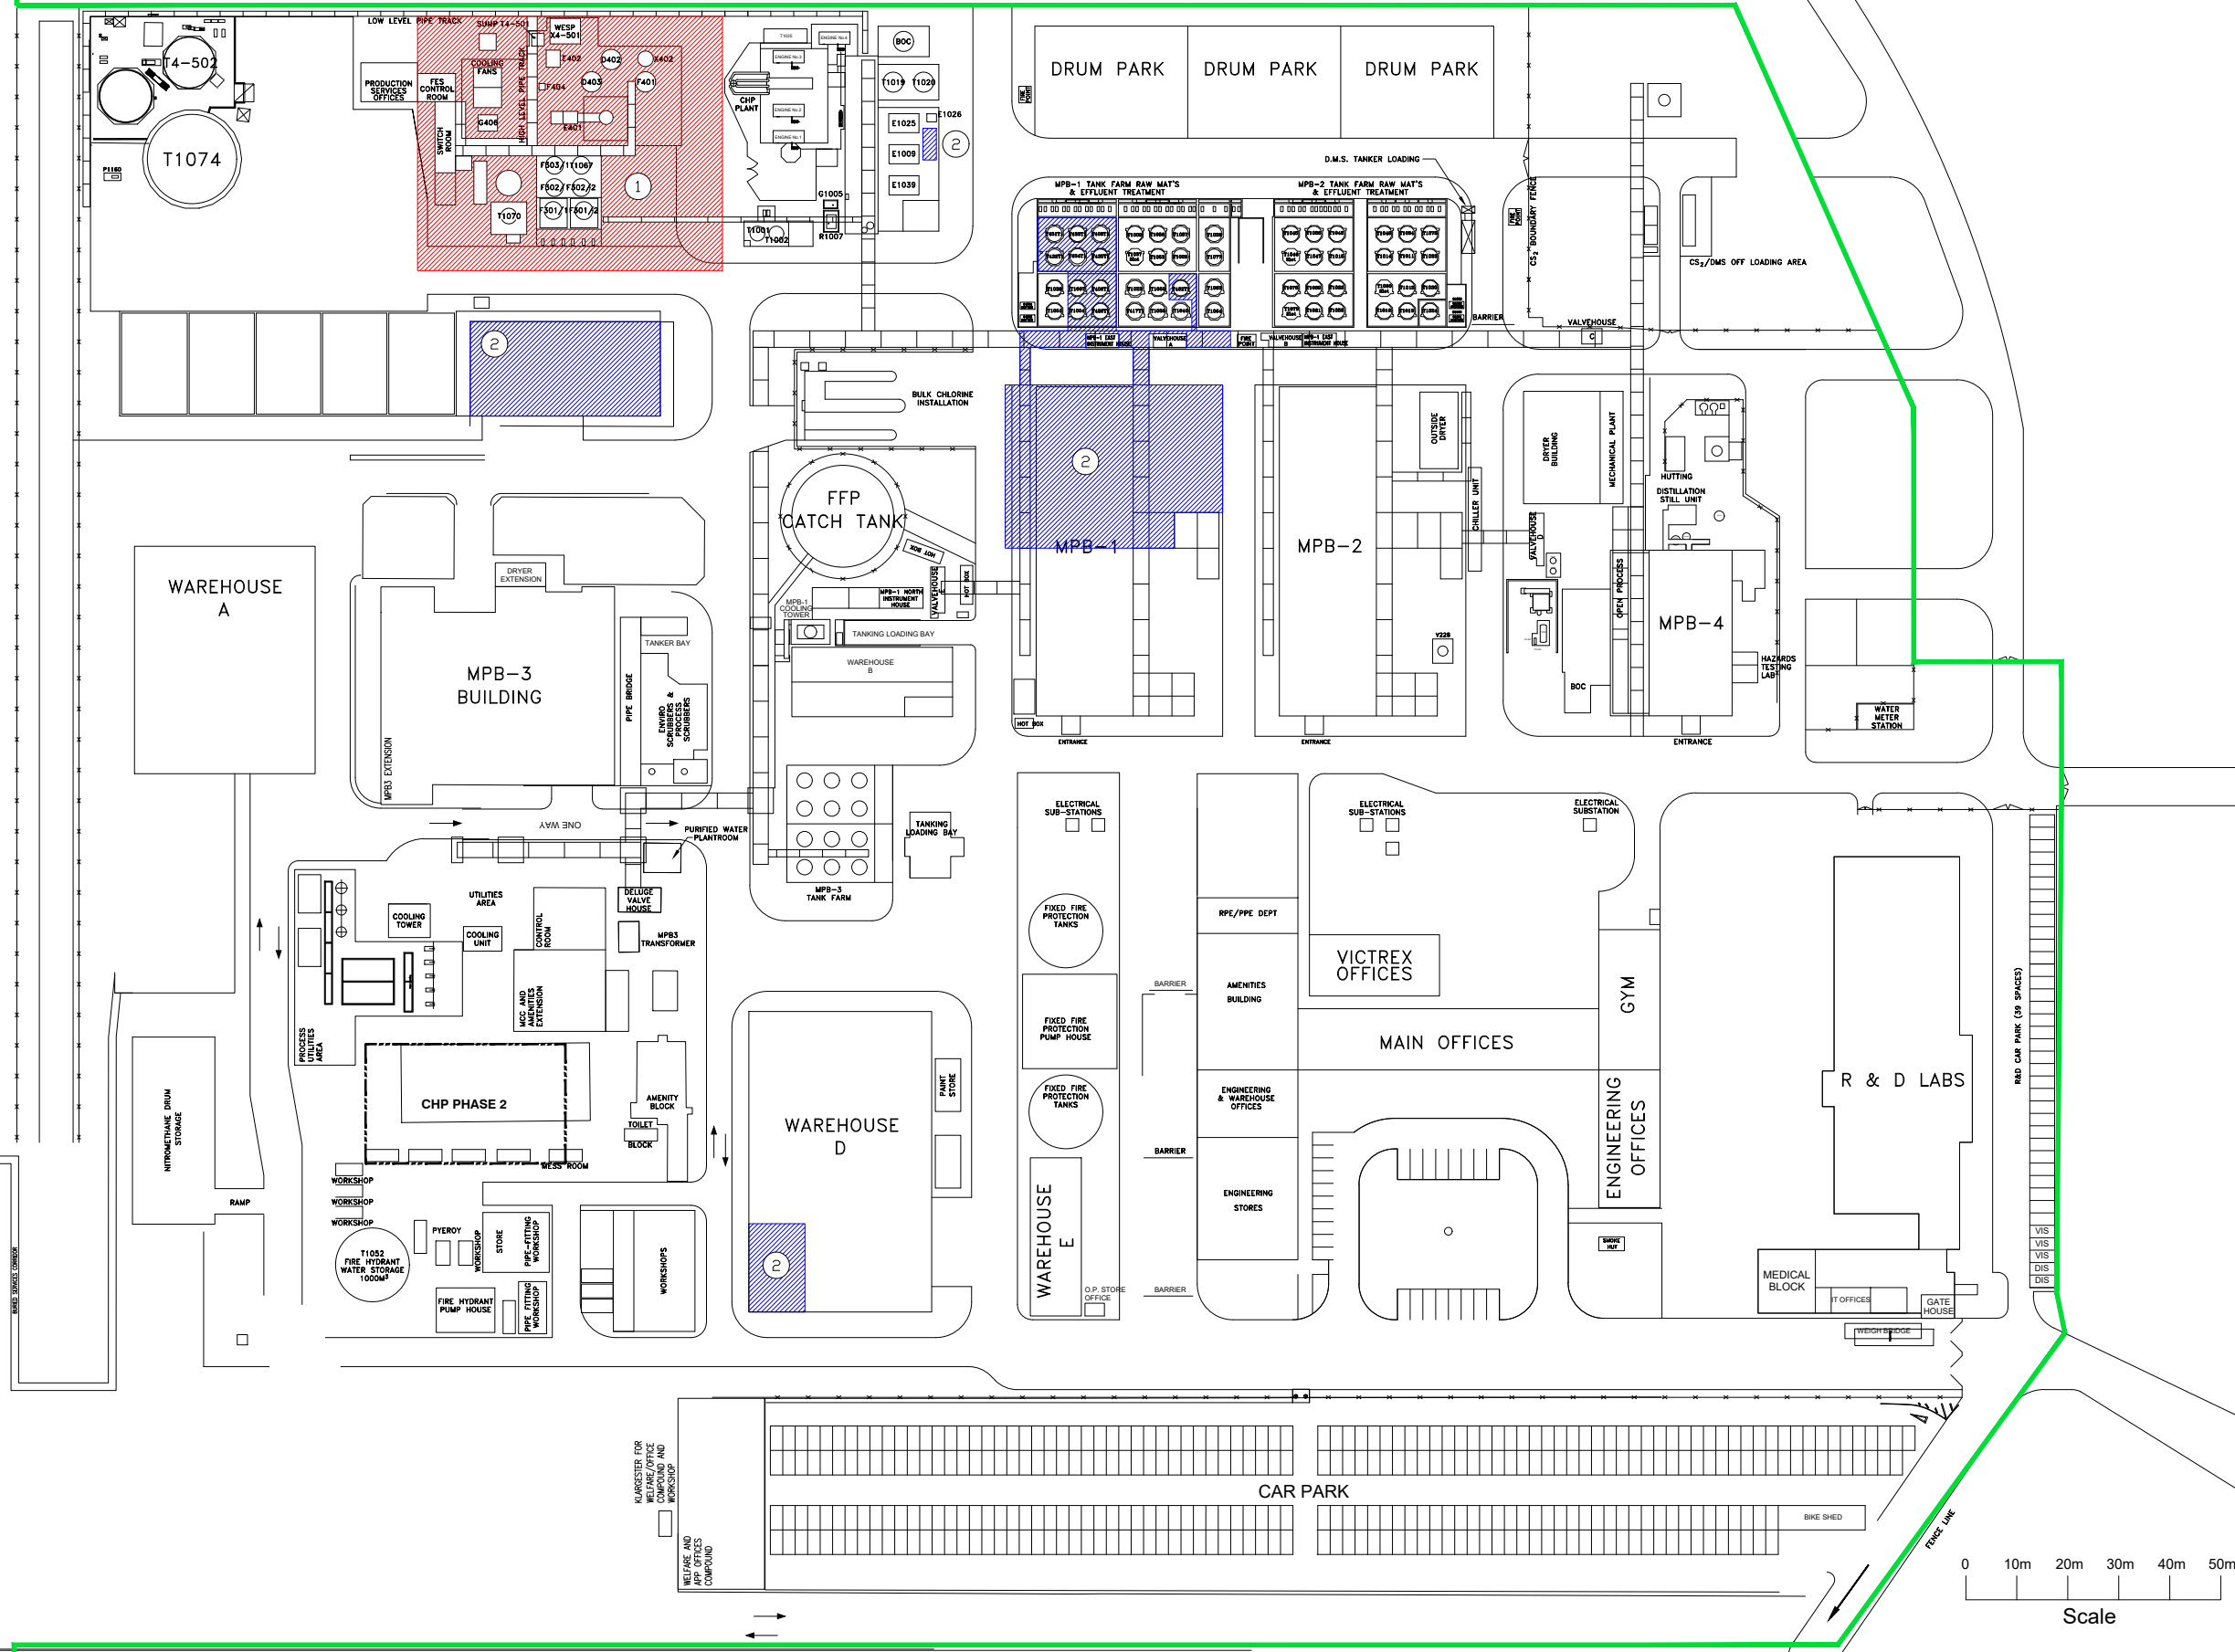

C	22.06.21	SITE LAYOUT	CW				
B	7.5.21	SITE LAYOUT	EPS				
A	29.1.15	SITE LAYOUT	ACD				

REV	DATE	DESCRIPTION OF REVISION	BY	PDM	PROC.	MECH.	INST.	PROD.
ISSUED FOR AS BUILT								
		CHECKED BY (Process Engineer)						
		Sig:	Date:.....					
		CHECKED BY (Instrument Engineer)						
		Sig:	Date:.....					
		APPROVED BY (Process Co-Ordinator.)						
		Sig:	Date:.....					

THIS DRAWING REMAINS THE PROPERTY OF
Lianhetch Seal Sands
 IT MUST NOT BE COPIED, LENT OR SHOWN TO THIRD PARTIES
 WITHOUT WRITTEN CONSENT OF THE COMPANY AND MUST BE
 RETURNED TO THE COMPANY ON DEMAND

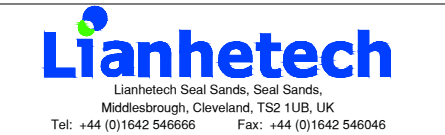


DRG No.	SL-0-1514	REV.	C
---------	-----------	------	---




TITLE FINE ORGANICS SEAL SANDS LAYOUT
 SHOWING FES,VICTREX BOUNDARIES

REFERENCE DRAWINGS	REFERENCE DRAWINGS

SCALE	1:500	CAD REF:--	SL01514--C.dwg
PROCESS NAME	N/A		
PLANT AREA	GENERAL SITE		
PROJECT NUMBER			
EQUIPMENT No.			

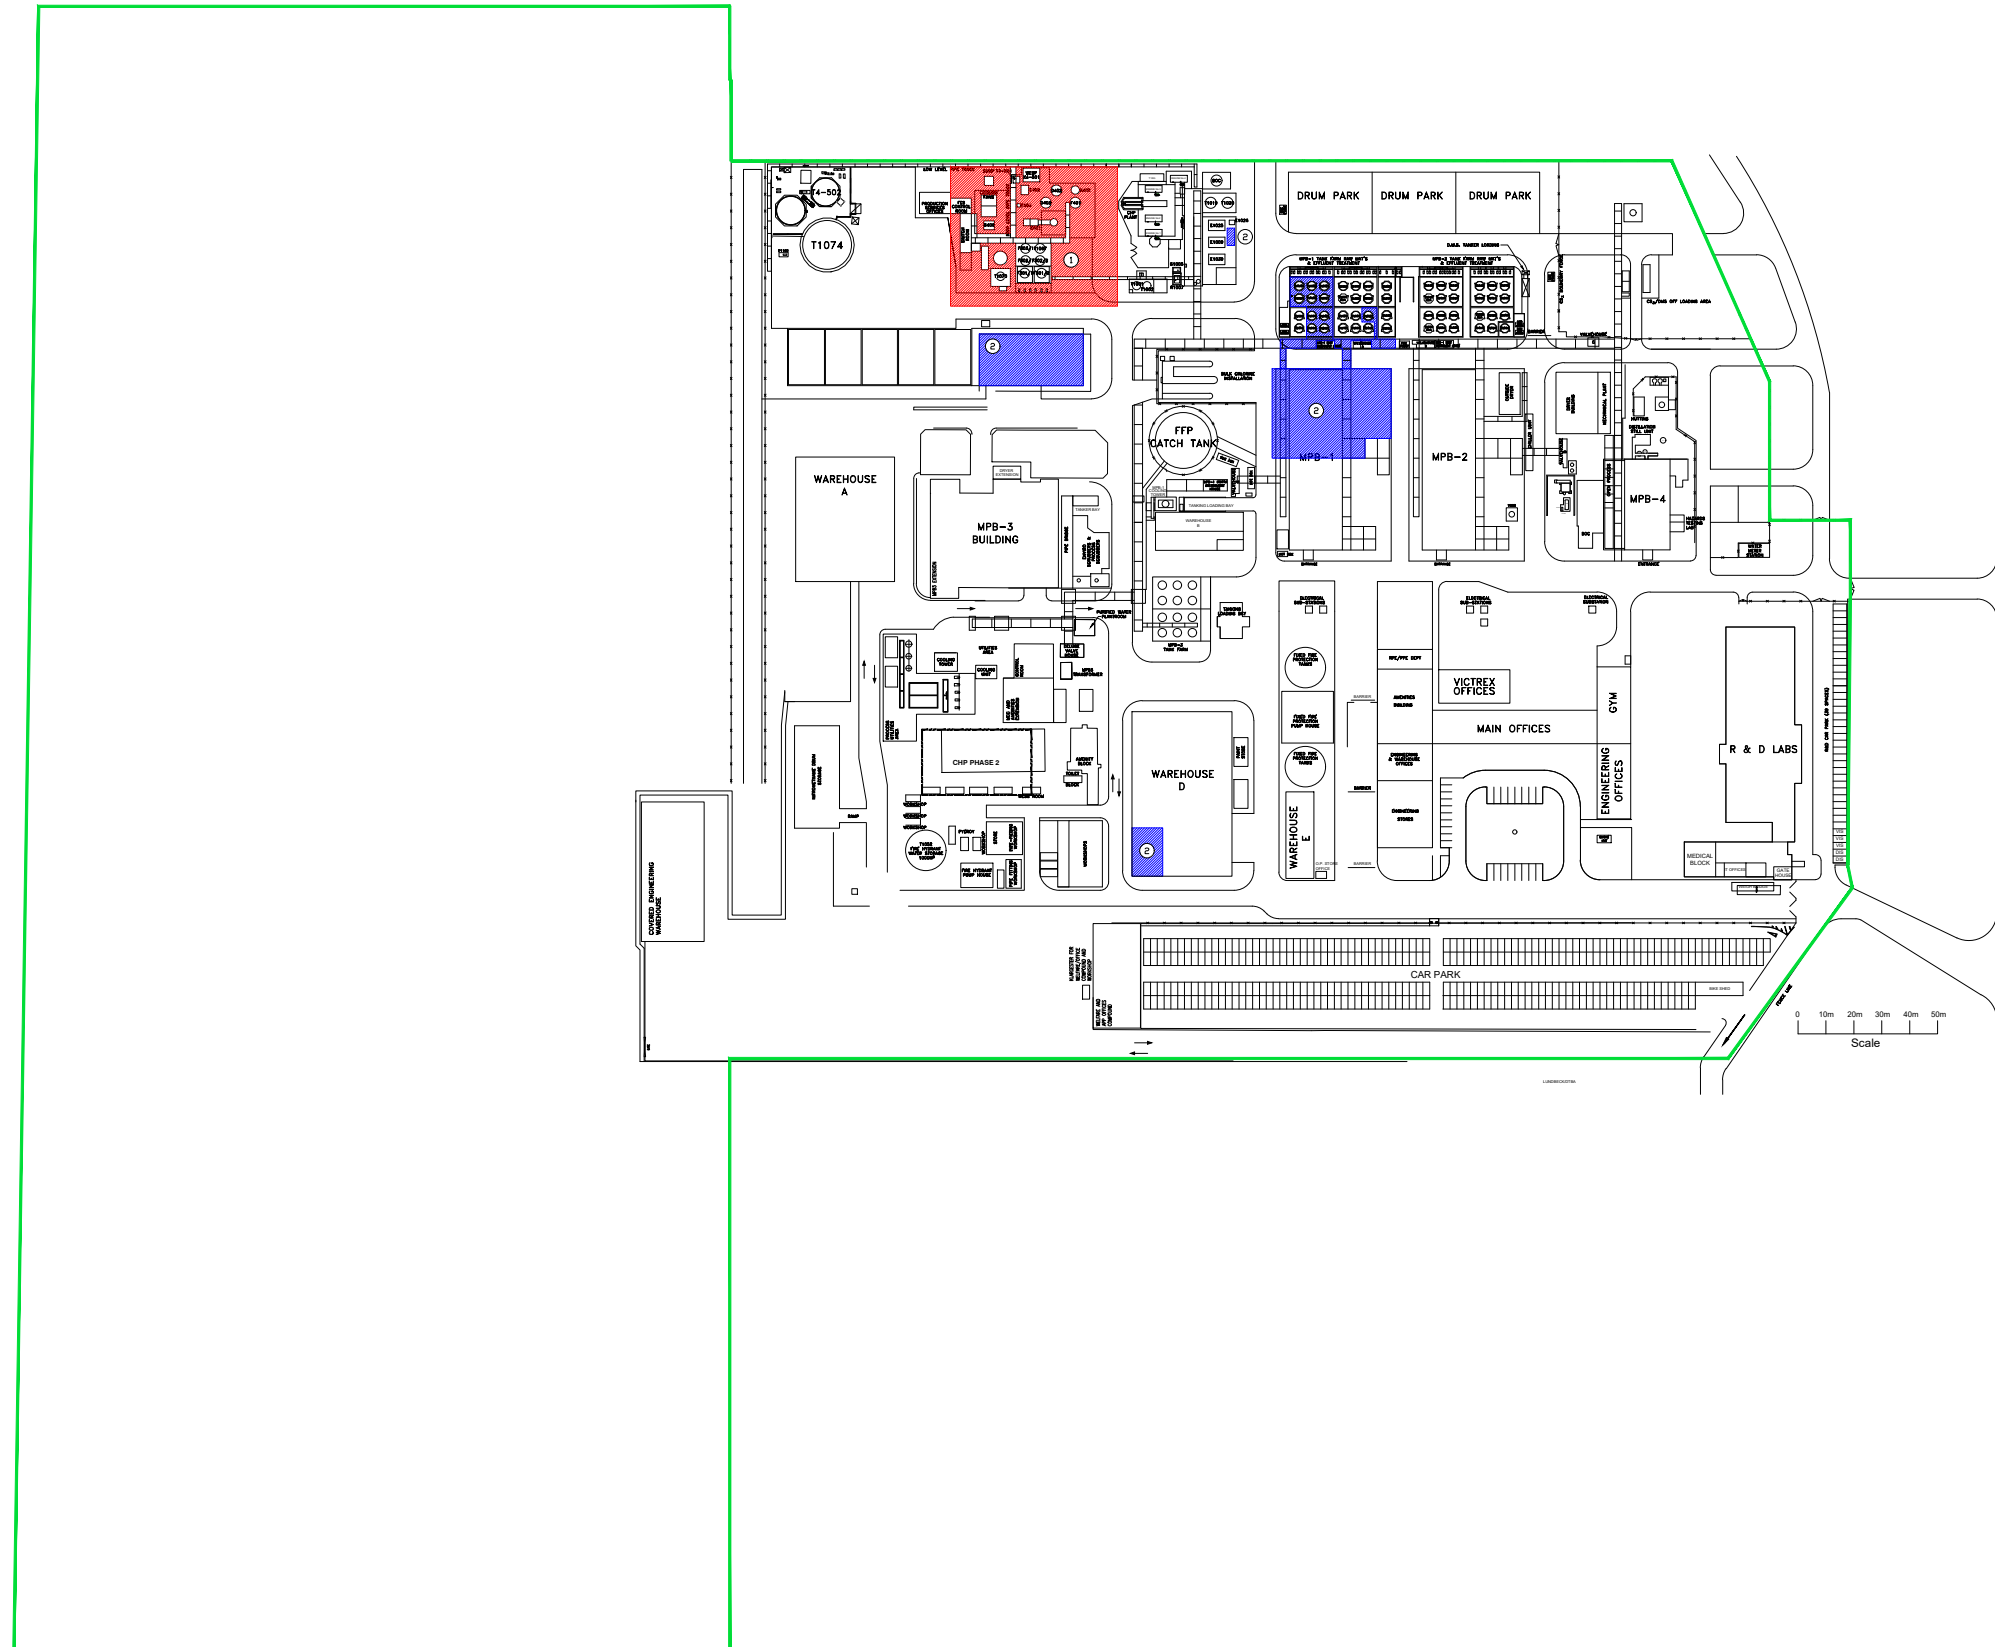

KEY

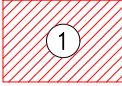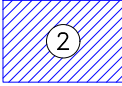-  PERMIT BOUNDARY FOR FINE ENVIRONMENTAL SERVICES
-  PERMIT BOUNDARY FOR VICTREX
-  SITE BOUNDARY

C	22.06.21	SITE LAYOUT	CW					
B	7.5.21	SITE LAYOUT	EPS					
A	29.1.15	SITE LAYOUT	ACD					
REV	DATE	DESCRIPTION OF REVISION	BY	PDM	PROC.	MECH.	INST.	PROD.

AS BUILT
ISSUED FOR

CHECKED BY (Process Engineer)
Sig: Date:.....

CHECKED BY (Instrument Engineer)
Sig: Date:.....

APPROVED BY (Process Co-Ordinator.)
Sig: Date:.....

THIS DRAWING REMAINS THE PROPERTY OF
Lianhetech Seal Sands
IT MUST NOT BE COPIED, LENT OR SHOWN TO THIRD PARTIES
WITHOUT WRITTEN CONSENT OF THE COMPANY AND MUST BE
RETURNED TO THE COMPANY ON DEMAND



DRG No. SL-0-1514A REV. C

TITLE LIANHETECH - SEAL SANDS - LAYOUT SHOWING SITE BOUNDARY

REFERENCE DRAWINGS	

REFERENCE DRAWINGS	

SCALE	1:1000	CAD REF:--	SL01514-C.dwg
PROCESS NAME	N/A		
PLANT AREA	GENERAL SITE		
PROJECT NUMBER			
EQUIPMENT No.			