


REV NO	DESCRIPTION	DRAWN BY	CHK'D BY	DATE
D	Emission and Sewer Discharge Points Added	J Davies	AE	08/12/14

Emission Points	
A6	APC Plant Mixer Extraction
A7	A8 Current Lime Filters (A7 to be removed A8 relocation shown in red)
A9, A10, A11, A12, A13, A14	APC Silo Filters
A15	Laboratory Snails Extraction
A16	T1, T2, T3, T4, Acid Process Extraction
A17	Shredder Extraction
A18	Cylinder Plant Extraction

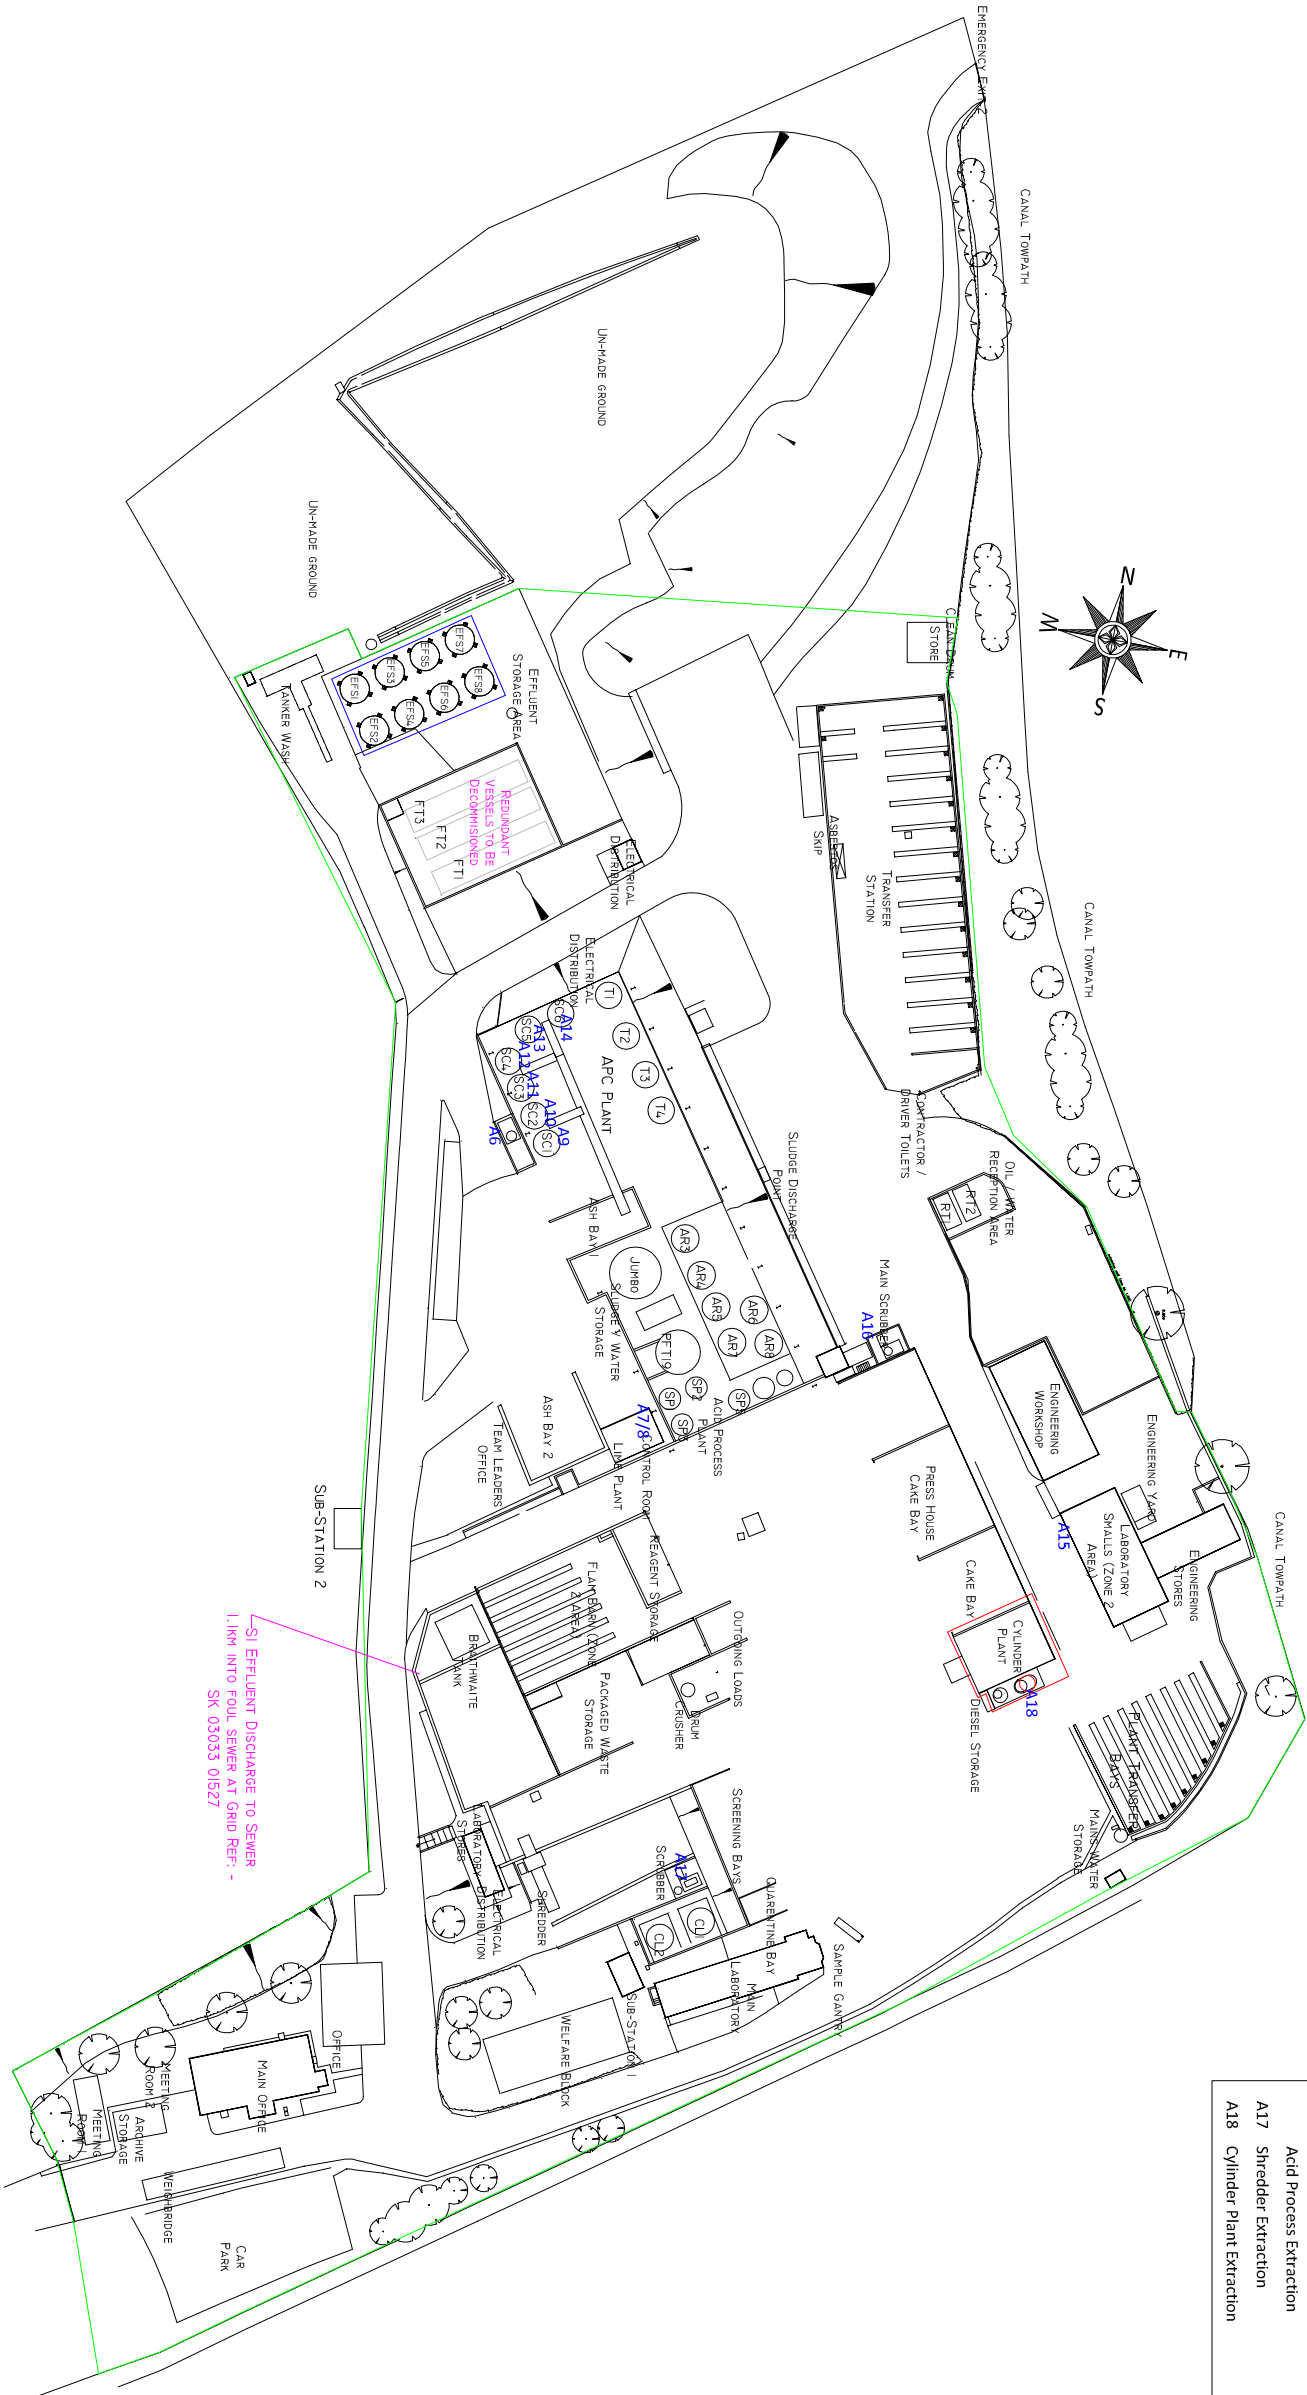

DRAWN BY	CHECKED BY	FILE NAME	DATE	SCALE
J DAVIES	JD	EMP_SL_0100_D	02/04/14	1:100

TITLE
EMPIRE WORKS SITE LAYOUT PLAN
EMISSION POINTS

DRAWING NO	SHEET
EMP_SL_0100/D	1 OF 1

