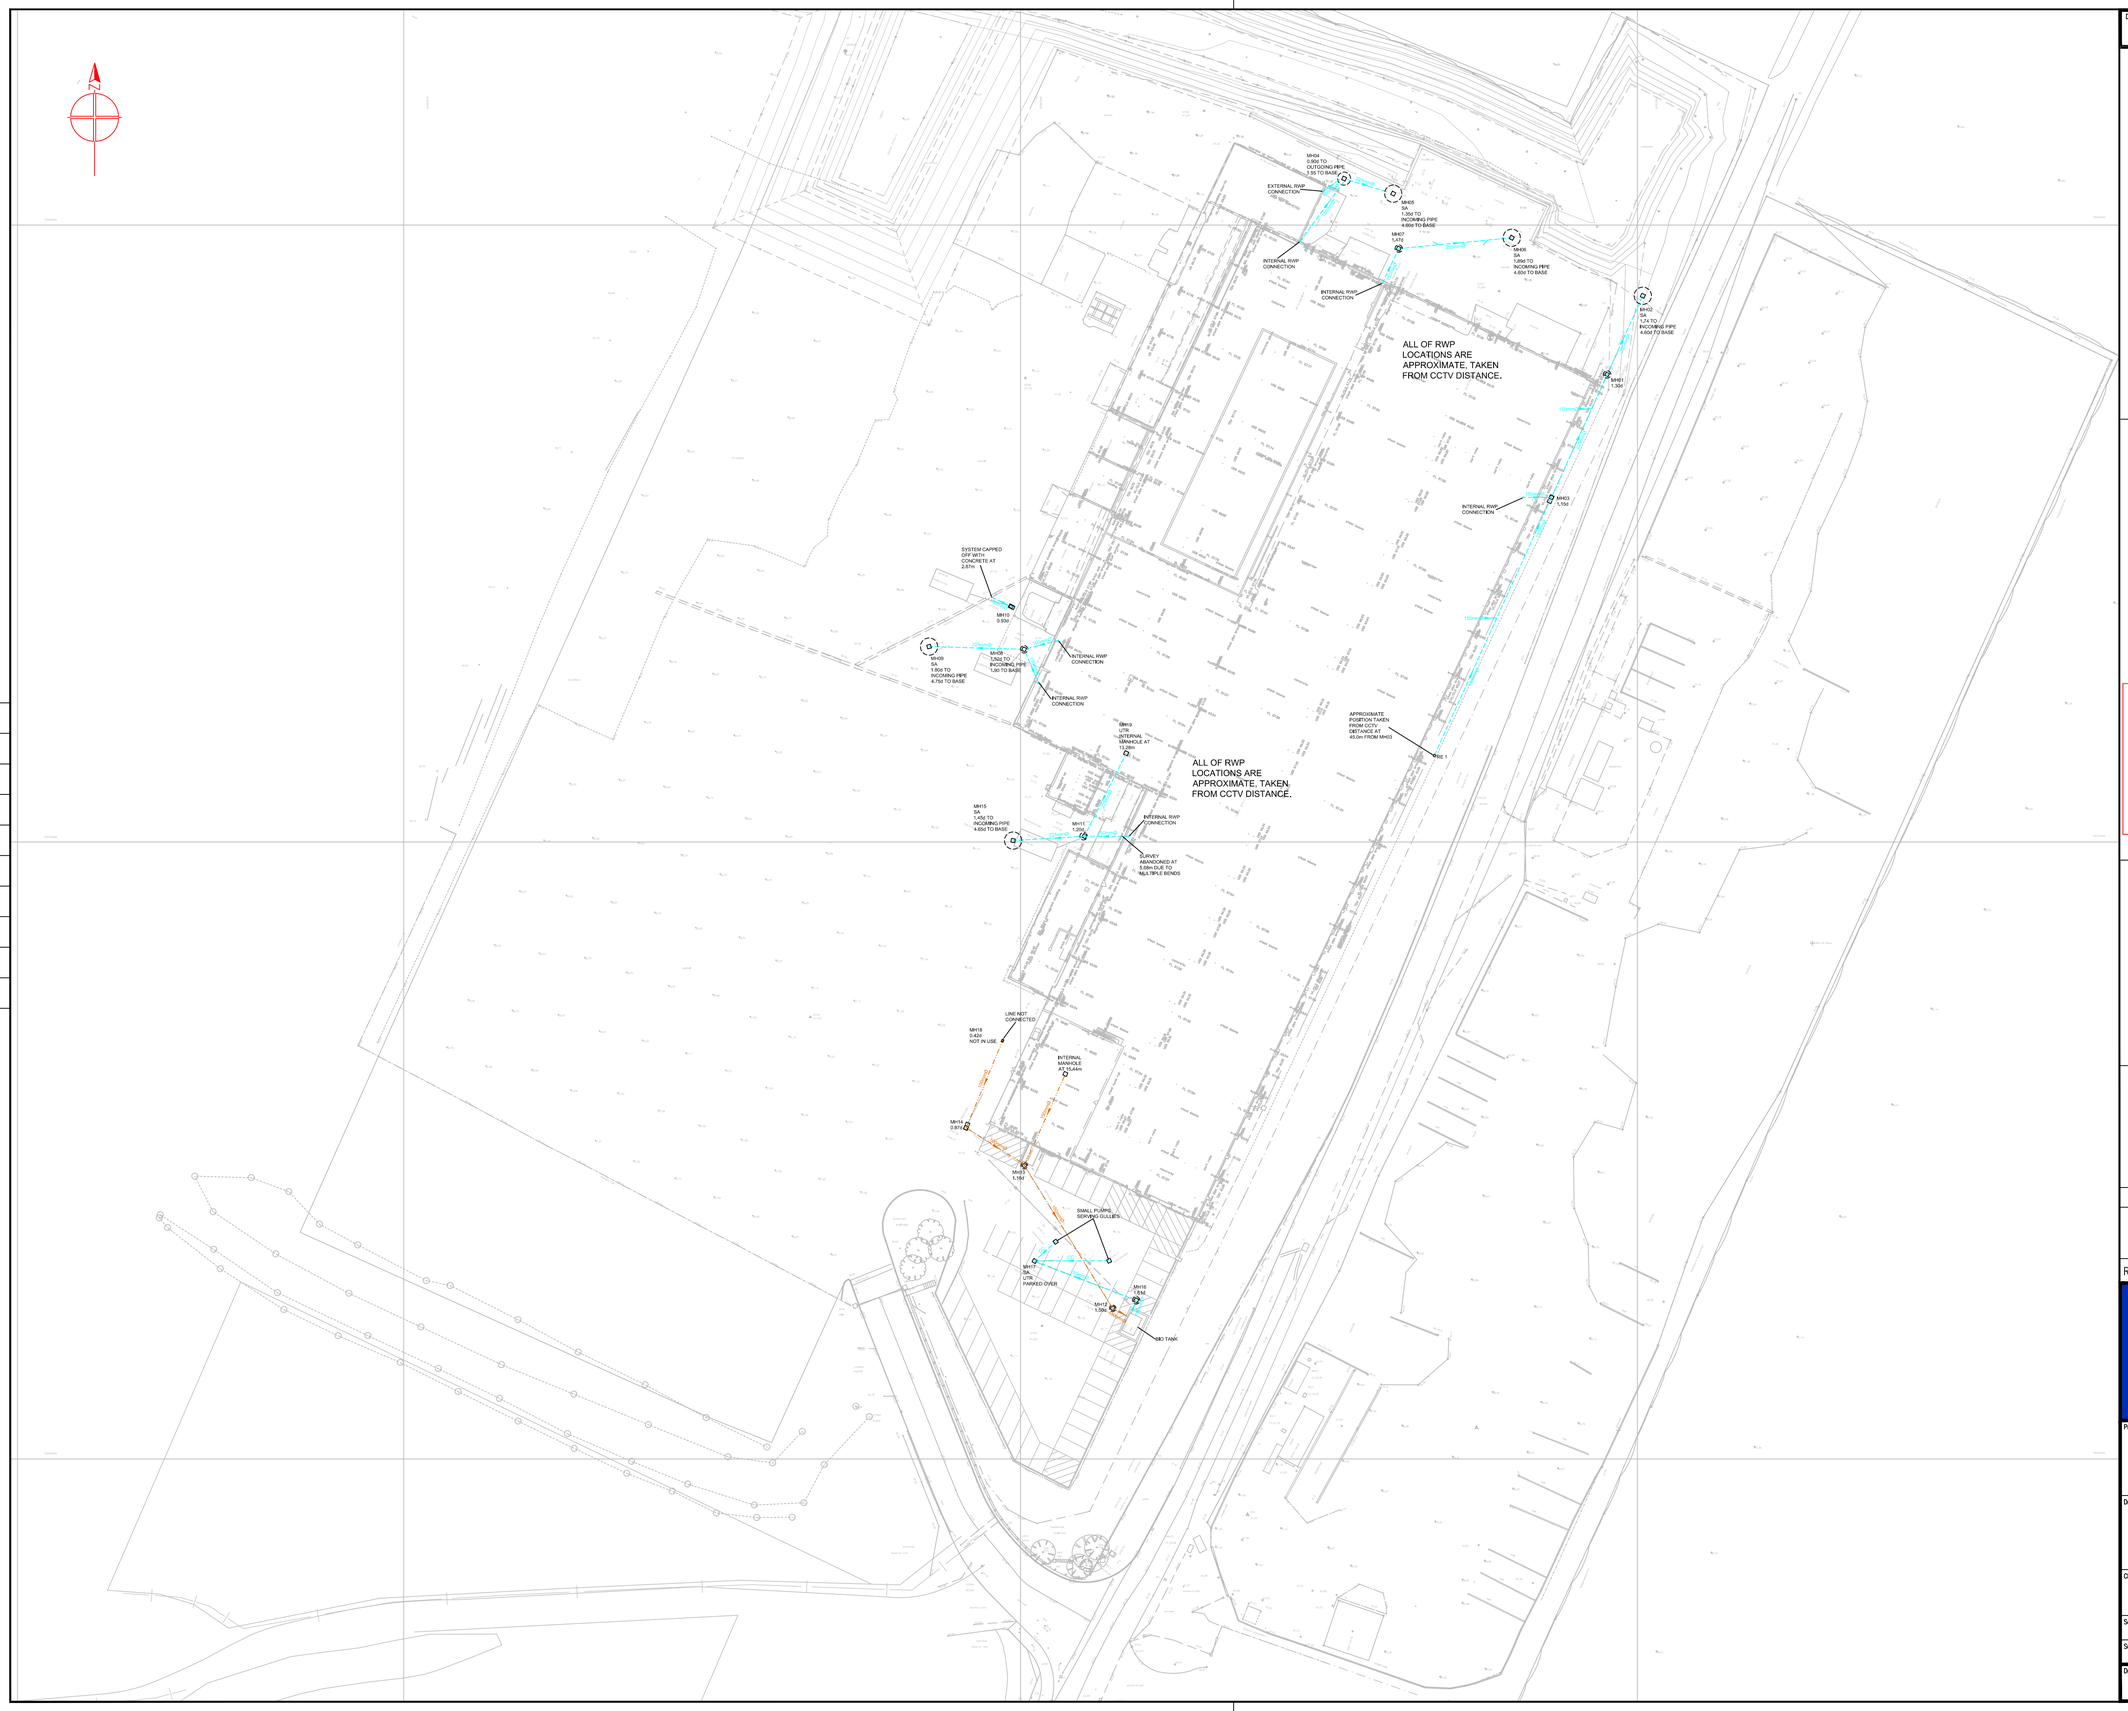

Drawing No.	Revision
SDS 205302.01	

SERVICE ABBREVIATIONS

AC	ASSUMED CONNECTION
AR	ASSUMED ROUTE
BD	BACK DROP
CC	CONFIRMED CONNECTION
CD	CHAMBER DEPTH
COW	CABLE ON WALL
CL	COVER LEVEL
CP	CATCH PIT
CB	CABLE RISER
d	DEPTH
(dis)	DISUSED
DP	DOWNPIPE
EOT	END OF TRACE
GU	GULLY
GPR (0.00)	GROUND PENETRATING RADAR (DEPTH)
IL	INVERT LEVEL
ICP	INTERCEPTOR
KIG	KERB INLET GULLY
MH	MANHOLE
OHL	OVER HEAD LINE
PI	PETROL INTERCEPTOR
RD	FROM RECORD DRAWINGS
RE	RODDING EYE
RWP	RAINWATER PIPE
SA	SOAKAWAY
SP	SOIL PIPE
UKN	UNKNOWN SERVICE
UTL	UNABLE TO LOCATE
UTR	UNABLE TO RAISE
UTT	UNABLE TO TRACE
UTS	UNABLE TO SURVEY

SERVICE LEGEND

FOUL WATER DRAINAGE	
SURFACE WATER DRAINAGE	
WATER	WATER
GAS	GAS
ELECTRICITY	ELEC
TELEPHONE	TEL
UNKNOWN SERVICE	UNK (EML)
OIL	OIL
CATV	CATV
GPR	GPR
FIBRE OPTIC	F_OPT
UNDERGROUND CHAMBER	

CAUTIONARY NOTES

ELECTRO–DETECTION TECHNIQUES HAVE BEEN USED IN THE LOCATION OF UNDERGROUND SERVICES. THE RESULTS ARE NOT INFALLIBLE AND TRIAL EXCAVATIONS MUST BE CARRIED OUT TO CONFIRM SERVICE IDENTIFICATION, POSITIONS AND PARTICULARLY DEPTHS. ALTHOUGH ALL REASONABLE EFFORT HAS BEEN MADE IN SEARCHING AVAILABLE RECORD DRAWINGS, THE COMPLETENESS OF THE UNDERGROUND SERVICE INFORMATION CANNOT BE GUARANTEED.
INFORMATION OBTAINED BY GPR IS INDICATIVE OF BURIED INFRASTRUCTURE THAT MAY NOT BE DETECTABLE BY OTHER MEANS.

Note: Pipe sizes in mm

CCTV NOTES

PIPES ON CCTV REPORT ARE REFERENCED CLOCKWISE FROM THE OUTGOING X PIPE. ENDPOINTS WITHIN BUILDINGS ARE INDICATIVE ONLY.

B C D A E X

LEVELLING NOTES

ALL LEVELS ARE BASED ON ORDNANCE SURVEY DATUM OBTAINED FROM ACTIVE GPS NETWORK "OSGB36(15)"

GRID IS BASED ON OS DATUM, OBTAINED FROM ACTIVE GPS NETWORK "OSGB36(15)"

ALL KERB LEVELS ARE TAKEN IN CHANNEL.

A SCALE FACTOR OF 1.000000 HAS BEEN APPLIED TO THIS DRAWING

Rev.	Date	Description	By

SURVEY DESIGN SERVICES and ASSOC. LTD.
UNITS 13 & 14 ,
THE FOUNDRY BUSINESS PARK,
SEAGER ROAD,
FAVERSHAM, KENT.
ME13 7FD
TEL 01795 594110
FAX 01795 530724
E-MAIL surveys@surveydesignservices.co.uk
TOPOGRAPHICAL LAND SURVEYS
MEASURED BUILDING SURVEYS
DRAINAGE INVESTIGATION
CCTV SURVEYS.
www.surveydesignservices.co.uk

Project title

PIKE ROAD EYTHORNE

Drawing title

DRAINAGE INVESTIGATION

Client

OVERDENS

Scales 1:500		Drawn by A.Z.	Sheet size A1
Surveyed by S.T.	Checked by P.D.	Approved by	Date NOV 2016

Drawing No.	Revision
SDS 205302.01	