



Key


Drainage/Sewer Lines

- Red Line
- Yellow Line
- Orange Line
- Black Line
- Purple Line
- Dark Blue Line
- Blue Line
- Brown Line
- Wastewater Treatment Plant/Former Lagoon Drainage
- Inferred Connection
- Roof Fall

Sample Locations

- Red Line Downpipe Sample Point
- Red Line Manhole Sample Point
- Yellow Line Downpipe Sample Point
- Yellow Line Manhole Sample Point
- Orange Line Downpipe Sample Point
- Orange Line Manhole Sample Point
- Black Line Manhole Sample Point
- Purple Line Downpipe Sample Point
- Purple Line Manhole Sample Point
- Dark Blue Line Downpipe Sample Point
- Blue Line Downpipe Sample Point
- Brown Line Manhole Sample Point
- Wastewater treatment Plant/Former Lagoon Sample Point
- Connecting Sample Point

Original Base Plan Produced by Adler & Allan (Ref: Fj00349798 Angus Fire Plan 24.7.24 V3), please reference original plan for Base Plan Key.

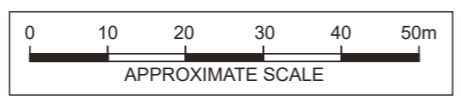

Factory Departments

- FP - Foam Production
- HFD - Hose Finishing Department
- LV - Long Length Vulcanising Department
- EPD - Engineering Products Department
- BHW - Bulk Hose Warehouse

Drainage Service Plan		
High Bentham, North Yorkshire	GCU0355001	
	Angus Fire Ltd	Figure 1
	Delph, UK	April 2025