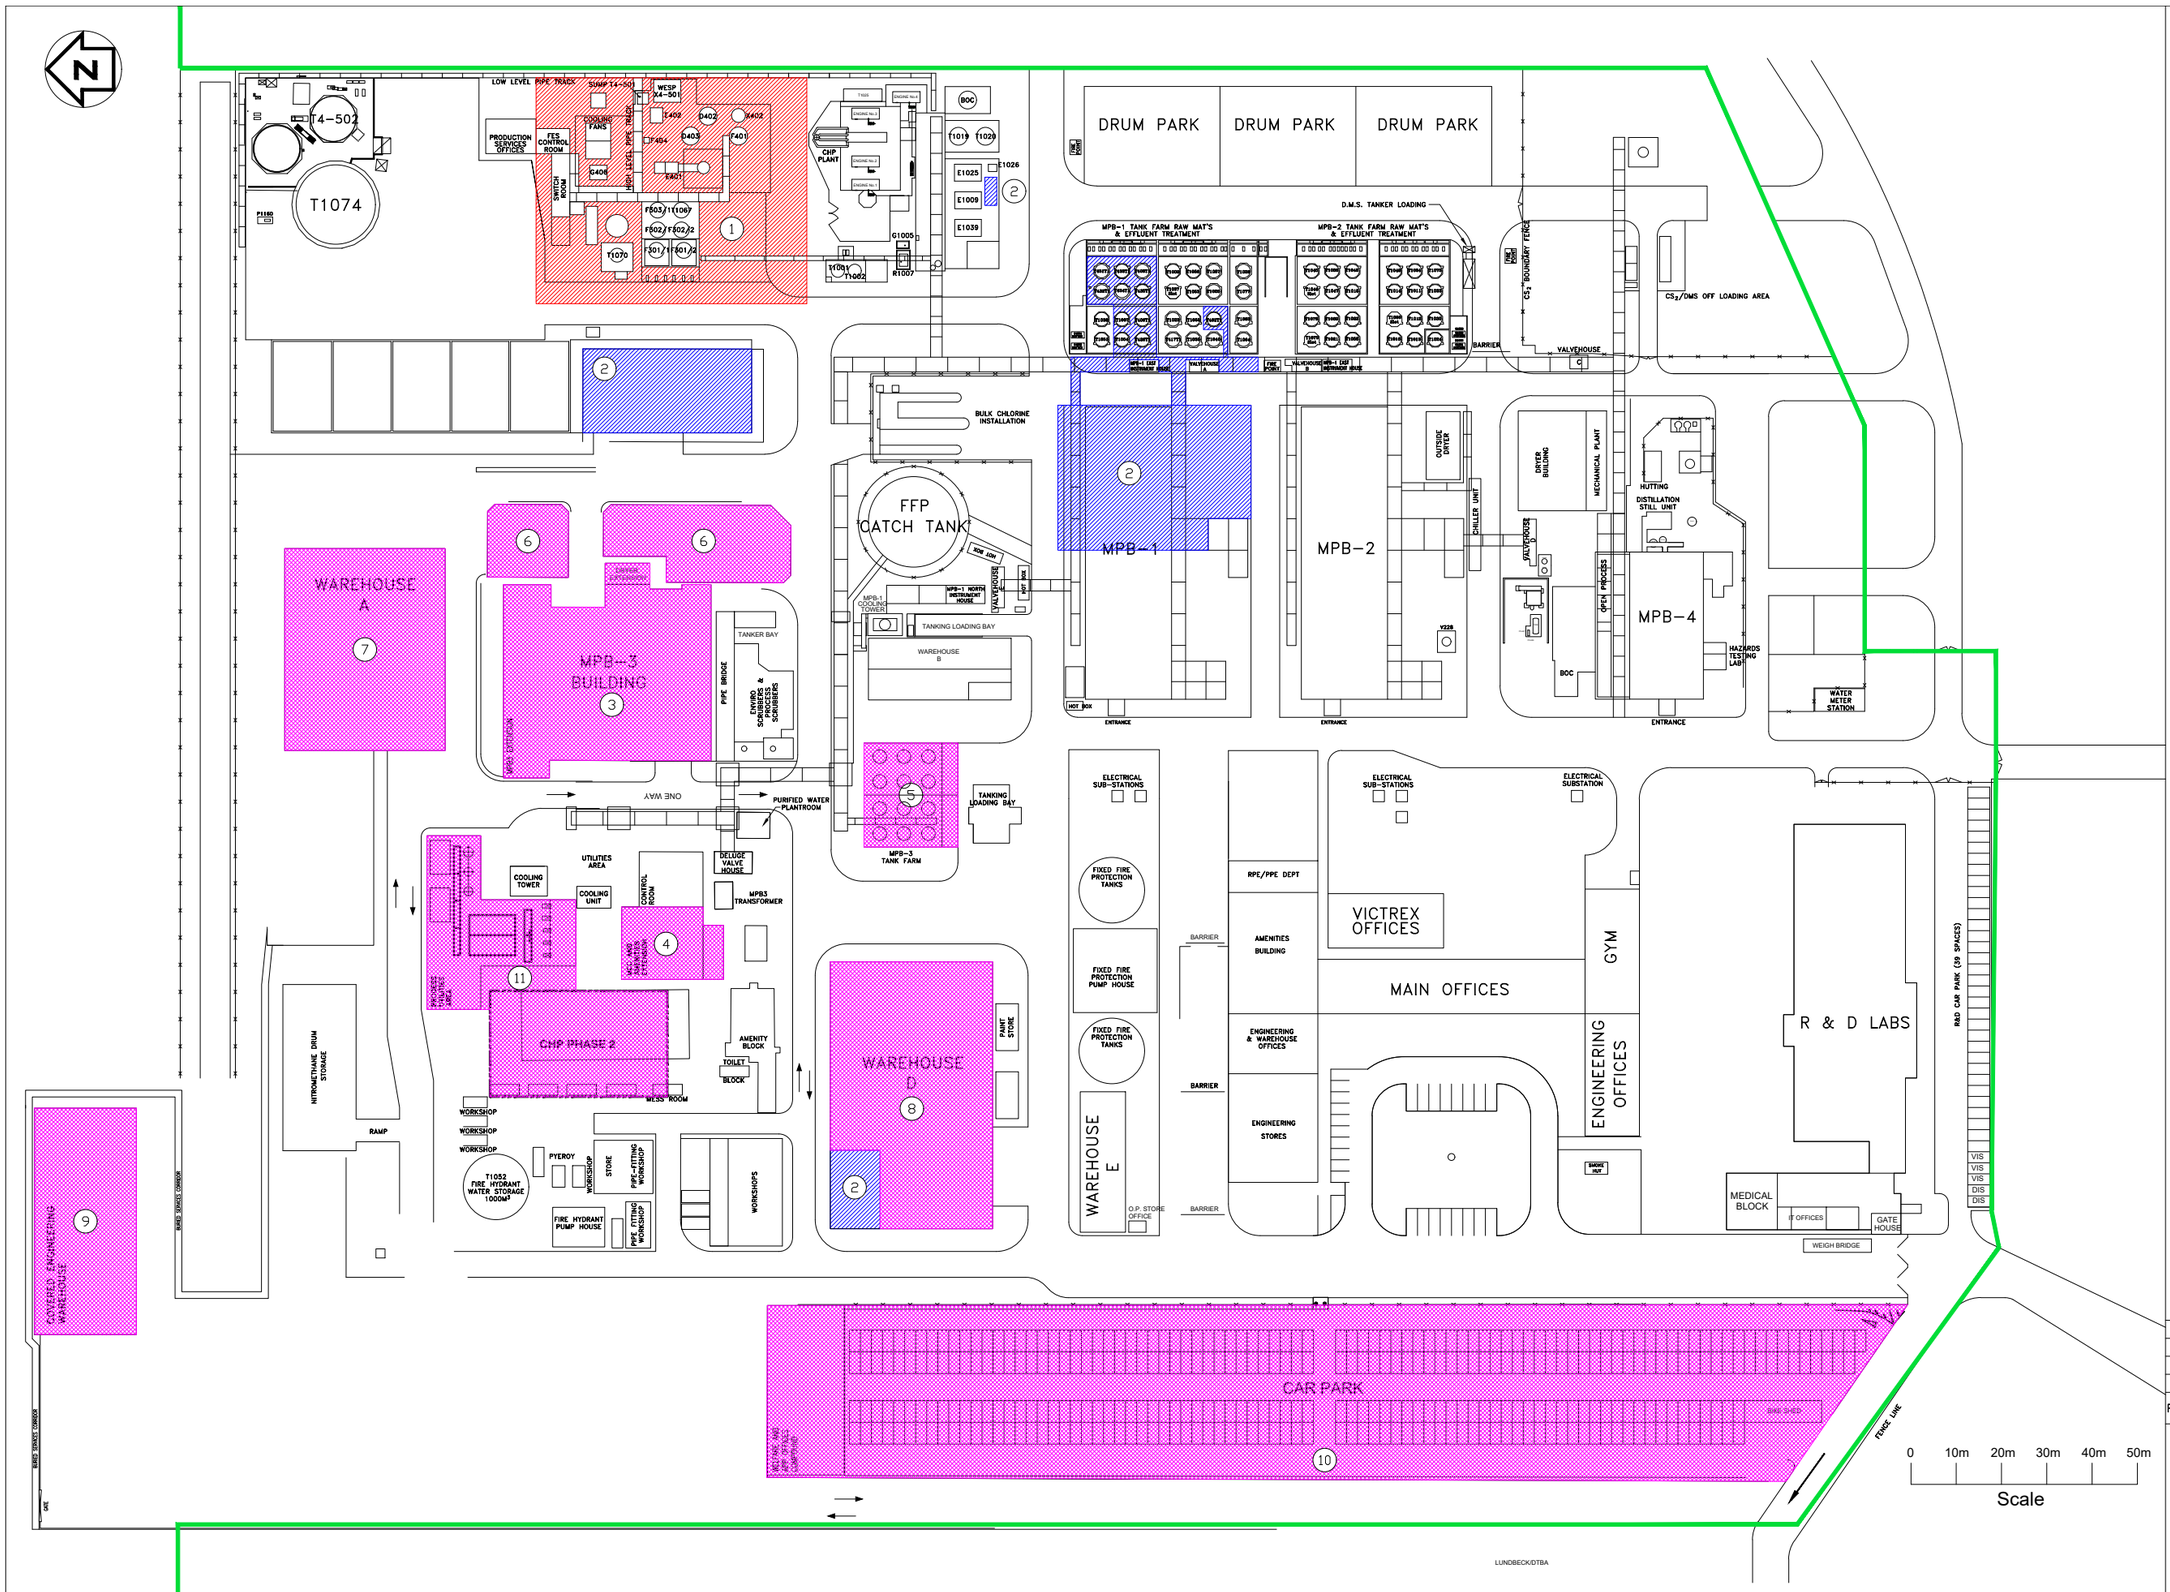

KEY

- 1 PERMIT BOUNDARY FOR FINE ENVIRONMENTAL SERVICES
- 2 PERMIT BOUNDARY FOR VICTREX
- SITE BOUNDARY
- 3 MPB-3 LC900 MANUFACTURING LOCATION
- 4 MPB-3 AMENITIES BUILDING
- 5 TANK FARM
- 6 ADDITIONAL BUNDS
- 7 WAREHOUSE A
- 8 WAREHOUSE D
- 9 ENGINEERING STORES
- 10 CAR PARK
- 11 UTILITIES

REV	DATE	DESCRIPTION OF REVISION	BY	PDM	PROC.	MECH.	INST.	PROD.
D	02.11.21	SITE LAYOUT	CW					
C	22.06.21	SITE LAYOUT	CW					
B	7.5.21	SITE LAYOUT	EPS					
A	29.1.15	SITE LAYOUT	ACD					

AS BUILT

ISSUED FOR .....

CHECKED BY (Process Engineer)

Sig: ..... Date:.....

CHECKED BY (Instrument Engineer)

Sig: ..... Date:.....

APPROVED BY (Process Co-Ordinator.)

Sig: ..... Date:.....

THIS DRAWING REMAINS THE PROPERTY OF
Lianhetech Seal Sands
IT MUST NOT BE COPIED, LENT OR SHOWN TO THIRD PARTIES WITHOUT WRITTEN CONSENT OF THE COMPANY AND MUST BE RETURNED TO THE COMPANY ON DEMAND

REFERENCE DRAWINGS

Lianhetech
Lianhetech Seal Sands, Seal Sands,
Middlesbrough, Cleveland, TS2 1UB, UK
Tel: +44 (0)1642 546666 Fax: +44 (0)1642 546046

REFERENCE DRAWINGS

DRG No.	SL-0-1514
REV.	D
TITLE	FINE ORGANICS SEAL SANDS LAYOUT SHOWING FES,VICTREX BOUNDARIES & V007 CHANGES TO SITE PLAN
SCALE	1:500
CAD REF:-	SL01514-D.dwg
PROCESS NAME	N/A
PLANT AREA	GENERAL SITE
PROJECT NUMBER	
EQUIPMENT No.	
	A0

LUNDBECK/DTBA